


1 LOCATION OF WATER WELL: County: Franklin Fraction: SE 1/4 SE 1/4 SE 1/4 Section Number: 24 Township Number: T 17 S Range Number: R 18 EW

Distance and direction from nearest town or city street address of well if located within city? 2N 1E Homewood

2 WATER WELL OWNER: John Harris John & Sue Houston
 RR#, St. Address, Box #: _____ Board of Agriculture, Division of Water Resources
 City, State, ZIP Code: Ottawa, KS Application Number: _____

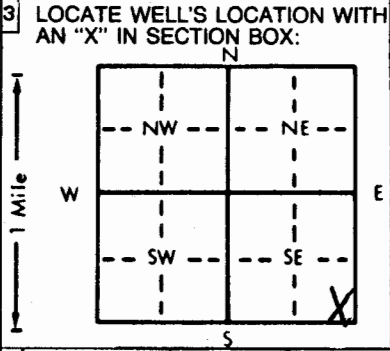

4 DEPTH OF COMPLETED WELL: 80 ft. ELEVATION: _____
 Depth(s) Groundwater Encountered: 1 71 ft. 2. _____ ft. 3. _____ ft.
 WELL'S STATIC WATER LEVEL: 42 ft. below land surface measured on mo/day/yr
 Pump test data: Well water was _____ ft. after _____ hours pumping _____ gpm
 Est. Yield: 3 gpm; Well water was _____ ft. after _____ hours pumping _____ gpm
 Bore Hole Diameter: 9 in. to 20 ft., and 6 1/4 in. to 80 ft.
 WELL WATER TO BE USED AS:
 1 Domestic 3 Feedlot 6 Oil field water supply 9 Dewatering 12 Other (Specify below)
 2 Irrigation 4 Industrial 7 Lawn and garden only 10 Observation well
 Was a chemical/bacteriological sample submitted to Department? Yes _____ No X; If yes, mo/day/yr sample was submitted _____
 Water Well Disinfected? Yes X No _____

5 TYPE OF BLANK CASING USED:
 1 Steel 3 RMP (SR) 5 Wrought iron 8 Concrete tile CASING JOINTS: Glued Clamped _____
 2 PVC 4 ABS 6 Asbestos-Cement 9 Other (specify below) Welded _____
 7 Fiberglass Threaded _____
 Blank casing diameter: 5 1/2 in. to 80 ft., Dia. _____ in. to _____ ft., Dia. _____ in. to _____ ft.
 Casing height above land surface: 18 in., weight 3ch 40 lbs./ft. Wall thickness or gauge No. 5ch 40
 TYPE OF SCREEN OR PERFORATION MATERIAL:
 1 Steel 3 Stainless steel 5 Fiberglass 7 PVC 10 Asbestos-cement
 2 Brass 4 Galvanized steel 6 Concrete tile 8 RMP (SR) 11 Other (specify) _____
 9 ABS 12 None used (open hole)
 SCREEN OR PERFORATION OPENINGS ARE:
 1 Continuous slot 3 Mill slot 5 Gauzed wrapped 8 Saw cut 11 None (open hole)
 2 Louvered shutter 4 Key punched 6 Wire wrapped 9 Drilled holes
 7 Torch cut 10 Other (specify) _____
 SCREEN-PERFORATED INTERVALS: From 60 ft. to 80 ft., From _____ ft. to _____ ft.
 GRAVEL PACK INTERVALS: From Non ft. to _____ ft., From _____ ft. to _____ ft.

6 GROUT MATERIAL: 1 Neat cement 2 Cement grout 3 Bentonite 4 Other _____
 Grout Intervals: From 4 ft. to 20 ft., From _____ ft. to _____ ft., From _____ ft. to _____ ft.
 What is the nearest source of possible contamination: None
 1 Septic tank 4 Lateral lines 7 Pit privy 10 Livestock pens 14 Abandoned water well
 2 Sewer lines 5 Cess pool 8 Sewage lagoon 11 Fuel storage 15 Oil well/Gas well
 3 Watertight sewer lines 6 Seepage pit 9 Feedyard 12 Fertilizer storage 16 Other (specify below)
 13 Insecticide storage
 Direction from well? None at The Time How many feet? _____

FROM	TO	LITHOLOGIC LOG
0	16	Soil & clay
16	41	yellow sand
41	60	Rock
60	71	gray shald
71	76	gray sand
76	80	white sand
		shald

RECEIVED

JUL 21 1989

DIVISION OF ENVIRONMENT

7 CONTRACTOR'S OR LANDOWNER'S CERTIFICATION: This water well was (1) constructed, (2) reconstructed, or (3) plugged under my jurisdiction and was completed on (mo/day/year) June 29, 1985 and this record is true to the best of my knowledge and belief. Kansas Water Well Contractor's License No. 371 This Water Well Record was completed on (mo/day/yr) July 15, 1985 under the business name of Swank Drilling by (signature) _____

INSTRUCTIONS: Use typewriter or ball point pen, PLEASE PRESS HEAVILY and PRINT clearly. Please fill in blanks, underline or circle the correct answers. Send top three copies to Kansas Department of Health and Environment, Division of Environment, Environmental Geology Section, Topeka, KS 66620. Send one to WATER WELL OWNER and retain one for your records.