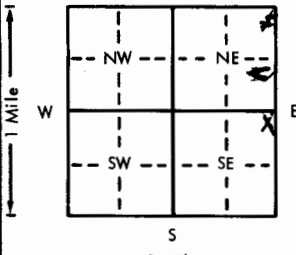
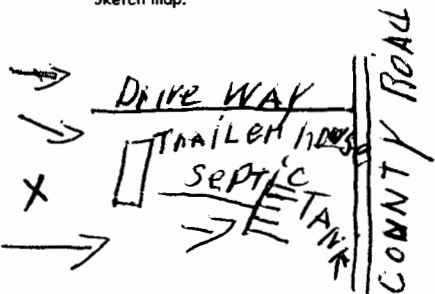


USE TYPEWRITER OR BALL
POINT PEN-PRESS FIRMLY,
PRINT CLEARLY.

WATER WELL RECORD
KSA 82a-1201-1215

Kansas Department of Health and
Environment-Division of Environment
(Water well Contractors)
Topeka, Kansas 66620

| | | | | | | |
|---|--|---|--------------------------------------|---|---------------------------------|---|
| 1. Location of well: | | County <u>Franklin</u> | Fraction <u>1/4 S. 1/4 S. 1/4</u> | Section number <u>26</u> | Township number <u>T. 17</u> | Range number <u>S. R. 18 E/W</u> |
| 2. Distance and direction from nearest town or city: <u>2 1/2 Mileswood</u> Street address of well location if in city: | | | | 3. Owner of well: <u>Jim Welch</u> R.R. or street: <u>R.R. 1</u> City, state, zip code: <u>Williamburg, Kansas</u> | | |
| 4. Locate with "X" in section below: | | Sketch map: | | 6. Bore hole dia. <u>8</u> in. Completion date <u>8-9-76</u> Well depth <u>87</u> ft. | | |
|  | |  | | 7. <input checked="" type="checkbox"/> Cable tool <input type="checkbox"/> Rotary <input type="checkbox"/> Driven <input type="checkbox"/> Dug <input type="checkbox"/> Hollow rod <input type="checkbox"/> Jetted <input type="checkbox"/> Bored <input type="checkbox"/> Reverse rotary | | |
| 5. Type and color of material | | | | From | To | 8. Use: <input checked="" type="checkbox"/> Domestic <input type="checkbox"/> Public supply <input type="checkbox"/> Industry <input type="checkbox"/> Irrigation <input type="checkbox"/> Air conditioning <input type="checkbox"/> Stock <input type="checkbox"/> Lawn <input type="checkbox"/> Oil field water <input type="checkbox"/> Other |
| <u>Soil & Clay</u> | | | | <u>0</u> | <u>13</u> | 9. Casing: Material <u>Aluminum</u> or below Threaded <input type="checkbox"/> Welded <input type="checkbox"/> Surface <u>18</u> in. RMP <input type="checkbox"/> PVC <input checked="" type="checkbox"/> Weight <u>305</u> lbs./ft. |
| <u>Yellow Sand Rock</u> | | | | <u>13</u> | <u>18</u> | Dia. <u>8</u> in. to <u>87</u> ft. depth Wall Thickness: inches or Dia. <u>8</u> in. to <u>87</u> ft. depth gage No. <u>255</u> |
| <u>Grey Sand</u> | | | | <u>18</u> | <u>67</u> | 10. Screen: Manufacturer's name <u>Core</u> Type <u>Core</u> Dia. <u>8</u> Slot/gauze <u>1/8</u> Length <u>10</u> Set between <u>13</u> ft. and <u>18</u> ft. <u>18</u> ft. and <u>67</u> ft. |
| <u>Greyish White Sand</u> | | | | <u>67</u> | <u>87</u> | Gravel pack? <input type="checkbox"/> Size range of material <u>10</u> |
| | | | | | | 11. Static water level: <u>60</u> ft. below land surface Date <u>8/76</u> mo./day/yr. |
| | | | | | | 14. Well head completion: <input checked="" type="checkbox"/> Pitless adapter <u>24</u> inches above grade |
| | | | | | | 15. Well grouted? <input checked="" type="checkbox"/> With: <u>Neat cement</u> <input type="checkbox"/> Bentonite <input type="checkbox"/> Concrete Depth: From <u>8</u> ft. to <u>20</u> ft. |
| | | | | | | 16. Nearest source of possible contamination: ft. <u>100</u> Direction <u>East</u> Type <u>Septic</u> Well disinfected upon completion? <input checked="" type="checkbox"/> Yes <input type="checkbox"/> No |
| | | | | | | 17. Pump: <input type="checkbox"/> Not installed Manufacturer's name <u>Red Jacket</u> Model number <u>374</u> HP <u>3/4</u> Volts <u>220</u> Length of drop pipe <u>80</u> ft. capacity <u>10</u> g.p.m. Type: <input type="checkbox"/> Submersible <input type="checkbox"/> Turbine <input type="checkbox"/> Jet <input type="checkbox"/> Reciprocating <input type="checkbox"/> Centrifugal <input type="checkbox"/> Other |
| (Use a second sheet if needed) | | | | | | |
| 18. Elevation: | | 19. Remarks: | | 20. Water well contractor's certification: | | |
| Topography: <input checked="" type="checkbox"/> Hill <input type="checkbox"/> Slope <input type="checkbox"/> Upland <input type="checkbox"/> Valley | | <u>This is a new home site. Cement slab will be poured as soon as the ground settles.</u> | | This well was drilled under my jurisdiction and this report is true to the best of my knowledge and belief. <u>Swank Drilling</u> <u>10/76</u> Business name <u>Swank Drilling</u> License No. <u>10/76</u> Address <u>R.R. 1, Ottawa, Kansas</u> Signed <u>Edgar Swank</u> Date <u>8-12-76</u> Authorized representative | | |

12 180E 26 NENESE
T R Sec 1/4 1/4 1/4