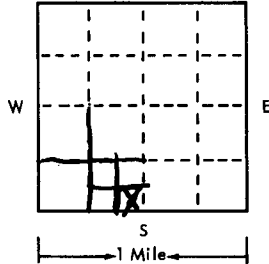
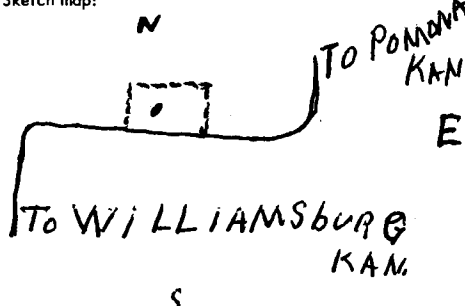


USE TYPEWRITER OR BALL
POINT PEN-PRESS FIRMLY,
PRINT CLEARLY.

WATER WELL RECORD
KSA 82a-1201-1215

T R EW sec 1/4 1/4 1/4 No.

Kansas State Dept. Of Health
(Water Well Contractors)
Forbes-Bldg. 740
Topeka, Kansas 66620

1 Location of well:	County FRANKLIN	Township name	Fraction SE 1/4 SW 1/4	Section number 30	Town number T17S	Range number R18E
Distance and direction from nearest town or city: 3 1/2 MI. NORTH EAST OF WILLIAMSBURG			3 Owner of well: Bud DUVAL Address: WILLIAMSBURG KANSAS			
Locate with "X" in section below: 		Sketch map: 				
2			Type and color of material		From	To
2 SOIL			2		2	2
15 LIME			17		2	17
5 BLACK SHALE			22		17	22
1 LIME			23		22	23
12 SHALE			35		23	35
2 LIME			37		35	37
2 SHALE			39		37	39
12 LIME			51		39	51
9 SOFT WHITE LIME			60		51	60
3 LIME			63		60	63
22 SHALE			85		63	85
(Seward) 28 GREY SAND			113 (1 GAL PER MIN)		85	113
(Robbins) 32 SHALE SHALE					113	145
(Haskell) 9 LIME					145	148
(Vinland) 48 GREY SANDED SHALE					148	180
(Jorgensen) 5 SAND					180	185
10 WHITE SAND					185	195
16 Remarks: elevation 1075' Topography: ☒ Hill ☐ Slope ☐ Upland ☐ Valley						
4 Well depth: 195 ft. Date of completion 4-3-75 Well diameter 6 in.					5 ☒ Cable tool ☐ Driven ☐ Dug ☐ Hollow rod ☐ Jetted ☐ Bored ☐ Reverse rotary	
6 Use: ☒ Domestic ☐ Public supply ☐ Industry ☐ Irrigation ☐ Air conditioning ☐ Commercial ☐ Test well ☐					7 Casing: Material PVC Height: above/below 18 in PVC Threaded ☒ Welded ☐ Surface 18 in PVC Diam. 6 in. to 22 ft. depth Drive shoe? ☐ Yes ☒ No 5 in. to 195 ft. depth	
8 Screen: PLASTIC CASING Manufacturer CROWN LINE Type 1120 Dia. 3" Slot/gauze 1/2" Length 90' Set between 175 ft. and 195 ft. Fittings: Gravel pack ☐ Yes ☒ No Size range of material					9 Static water level: 100 ft. below land surface Date 4-3-75	
10 Pumping level below land surfaces: 100 ft. after 1 hrs. pumping 1 g.p.m. 100 ft. after 1 hrs. pumping 1 g.p.m. Estimated maximum yield 1 g.p.m.					11 Water sample submitted: ☐ Yes ☒ No Date	
12 Well head completion: ☐ Pitless adapter ☐ Inches above grade					13 Well grouted? ☒ Yes ☐ No ☒ Neat cement ☐ Bentonite ☐ Depth: From 22 ft. to 22 ft.	
14 Nearest source of possible contamination: ft. NA Direction NA Type NA Well disinfected upon completion? ☒ Yes ☐ No					15 Pump: ☐ Not installed Manufacturer's name RED JACKET Model number 575W HP 3/4 Volts 220 Length of drop pipe 185 ft. capacity 5 g.m.p. Type: ☒ Submersible ☐ Turbine ☐ Jet ☐ Reciprocating ☐ Centrifugal ☐ Other	
17 Water well contractor's certification: This well was drilled under my jurisdiction and this report is true to the best of my knowledge and belief. EDGAR SWANK 134 Business name OTTAWA KANSAS License No. Address Edgar Swank Date 4-21-75 Signed Edgar Swank Authorized representative						

Forward the white, blue and pink copies to the Kansas State Dept. Of Health.

Form WWC-5