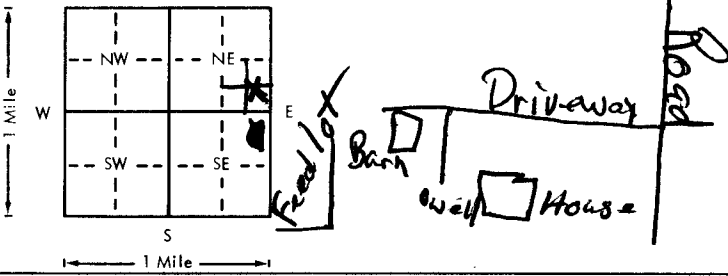


USE TYPEWRITER OR BALL
POINT PEN-PRESS FIRMLY,
PRINT CLEARLY.

WATER WELL RECORD
KSA 82a-1201-1215

Kansas Department of Health and
Environment-Division of Environment
(Water well Contractors)
Topeka, Kansas 66620

1. Location of well:		County Franklin	Fraction SE 1/4 NE 1/4	Section number 31	Township number T 17 S	Range number R 18 E
2. Distance and direction from nearest town or city 5 1/2 South			3. Owner of well: Lantis Hart			
Street address of well location if in city: Pomona			City, state, zip code: Pomona, Kan 66076-2479			
4. Locate with "X" in section below:		Sketch map:		6. Bore hole dia. 8 1/2 in. Completion date 1-24-79 Well depth 195 ft. 9" to 20"		
				7. <input checked="" type="checkbox"/> Cable tool <input type="checkbox"/> Rotary <input type="checkbox"/> Driven <input type="checkbox"/> Dug <input type="checkbox"/> Hollow rod <input type="checkbox"/> Jetted <input type="checkbox"/> Bored <input type="checkbox"/> Reverse rotary		
5. Type and color of material		From	To	8. Use: <input checked="" type="checkbox"/> Domestic <input type="checkbox"/> Public supply <input type="checkbox"/> Industry <input type="checkbox"/> Irrigation <input type="checkbox"/> Air conditioning <input type="checkbox"/> Stock <input type="checkbox"/> Lawn <input type="checkbox"/> Oil field water <input type="checkbox"/> Other		
soil		0	5	9. Casing: Material <input type="checkbox"/> Height: Above or below Threaded <input type="checkbox"/> Welded <input type="checkbox"/> Surface 18 in. RMP <input type="checkbox"/> PVC <input checked="" type="checkbox"/> Weight sch 40 lbs./ft. Dia. 8 1/2 in. to 20 ft. depth Wall Thickness: inches or Dia. 5 in. to 195 ft. depth Gauge No. sch 40		
				10. Screen: Manufacturer's name crown line Type PVC Dia. 5 Slot/gauze 3/8 Length 30 Set between 32 165 ft. and 195 ft. ft. and ft. Gravel pack? no Size range of material		
				11. Static water level: 100 ft. below land surface Date 1-24-79 mo./day/yr.		
				12. Pumping level below land surfaces: ft. after hrs. pumping g.p.m. ft. after hrs. pumping g.p.m. Estimated maximum yield 10 g.p.m.		
				13. Water sample submitted: <input checked="" type="checkbox"/> Yes <input checked="" type="checkbox"/> No Date		
				14. Well head completion: <input checked="" type="checkbox"/> Pitless adapter <input type="checkbox"/> Inches above grade		
				15. Well grouted? <input type="checkbox"/> With: <input checked="" type="checkbox"/> Neat cement <input type="checkbox"/> Bentonite <input type="checkbox"/> Concrete Depth: From 3' ft. to 20' ft.		
				16. Nearest source of possible contamination: ft. 80 Direction west Type feed lot Well disinfected upon completion? <input type="checkbox"/> Yes <input type="checkbox"/> No		
				17. Pump: <input checked="" type="checkbox"/> Not installed Manufacturer's name <input type="checkbox"/> Model number <input type="checkbox"/> HP <input type="checkbox"/> Volts <input type="checkbox"/> Length of drop pipe <input type="checkbox"/> ft. capacity <input type="checkbox"/> g.p.m. Type: <input type="checkbox"/> Submersible <input type="checkbox"/> Turbine <input type="checkbox"/> Jet <input type="checkbox"/> Reciprocating <input type="checkbox"/> Centrifugal <input type="checkbox"/> Other		
		(Use a second sheet if needed)				
18. Elevation:		19. Remarks:		20. Water well contractor's certification: This well was drilled under my jurisdiction and this report is true to the best of my knowledge and belief. Royce swank Drilling 371 Business name License No. Address RR1, Swank Ottawa Kan. Signed Royce Swank Date 3-9-79 Authorized representative		
Topography: <input type="checkbox"/> Hill <input type="checkbox"/> Slope <input checked="" type="checkbox"/> Upland <input type="checkbox"/> Valley						

Forward the white, blue and pink copies to the Department of Health and Environment

Form WWC-5