


1 LOCATION OF WATER WELL: County: FRANKLIN Fraction: NE 1/4 SW 1/4 SE 1/4 Section Number: 18 Township Number: T 17 S Range Number: R 18 EW

Distance and direction from nearest town or city street address of well if located within city?  
3 MILE SOUTH OF THE CITY OF POMONA, KS.

2 WATER WELL OWNER: BRAD FOSTER / KIMBERLY WARD  
 RR#, St. Address, Box #: RR # 1 2526 COLORADO RD  
 City, State, ZIP Code: POMONA, KS 66076  
 Board of Agriculture, Division of Water Resources  
 Application Number: \_\_\_\_\_

3 LOCATE WELL'S LOCATION WITH AN "X" IN SECTION BOX:

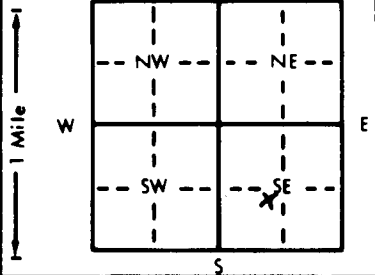

4 DEPTH OF COMPLETED WELL: 270 ft. ELEVATION: \_\_\_\_\_  
 Depth(s) Groundwater Encountered: 1. 2.18 ft. 2. \_\_\_\_\_ ft. 3. \_\_\_\_\_ ft.  
 WELL'S STATIC WATER LEVEL: 107 ft. below land surface measured on mo/day/yr: 6/1/99  
 Pump test data: Well water was \_\_\_\_\_ ft. after \_\_\_\_\_ hours pumping \_\_\_\_\_ gpm  
 Est. Yield: 10 gpm. Well water was \_\_\_\_\_ ft. after \_\_\_\_\_ hours pumping \_\_\_\_\_ gpm  
 Bore Hole Diameter: 8.625 in. to \_\_\_\_\_ ft. and \_\_\_\_\_ in. to \_\_\_\_\_ ft.  
 WELL WATER TO BE USED AS:  
 1 Domestic     3 Feedlot     6 Oil field water supply     8 Air conditioning     11 Injection well  
 2 Irrigation     4 Industrial     7 Lawn and garden only     9 Dewatering     12 Other (Specify below)  
 Was a chemical/bacteriological sample submitted to Department? Yes \_\_\_\_\_ No  If yes, mo/day/yr sample was submitted \_\_\_\_\_  
 Water Well Disinfected? Yes  No \_\_\_\_\_

5 TYPE OF BLANK CASING USED:  
 1 Steel     3 RMP (SR)     5 Wrought iron     8 Concrete tile    CASING JOINTS:  Glued    \_\_\_\_\_ Clamped  
 2 PVC     4 ABS     6 Asbestos-Cement     9 Other (specify below)    \_\_\_\_\_ Welded  
 \_\_\_\_\_     7 Fiberglass    \_\_\_\_\_ Threaded  
 Blank casing diameter: 5 in. to 2.30 ft. Dia. \_\_\_\_\_ in. to \_\_\_\_\_ ft. Dia. \_\_\_\_\_ in. to \_\_\_\_\_ ft.  
 Casing height above land surface: 24 in., weight \_\_\_\_\_ lbs./ft. Wall thickness or gauge No. SDR 26

TYPE OF SCREEN OR PERFORATION MATERIAL:  
 1 Steel     3 Stainless steel     5 Fiberglass     7 PVC     10 Asbestos-cement  
 2 Brass     4 Galvanized steel     6 Concrete tile     8 RMP (SR)     11 Other (specify) \_\_\_\_\_  
 \_\_\_\_\_     9 ABS     12 None used (open hole)  
 SCREEN OR PERFORATION OPENINGS ARE:  
 1 Continuous slot     3 Mill slot     5 Gauzed wrapped     8 Saw cut     11 None (open hole)  
 2 Louvered shutter     4 Key punched     6 Wire wrapped     9 Drilled holes  
 \_\_\_\_\_     7 Torch cut     10 Other (specify) \_\_\_\_\_  
 SCREEN-PERFORATED INTERVALS: From 2.30 ft. to 2.70 ft. From \_\_\_\_\_ ft. to \_\_\_\_\_ ft.  
 From \_\_\_\_\_ ft. to \_\_\_\_\_ ft. From \_\_\_\_\_ ft. to \_\_\_\_\_ ft.  
 GRAVEL PACK INTERVALS: From 2.5 ft. to 2.70 ft. From \_\_\_\_\_ ft. to \_\_\_\_\_ ft.  
 From \_\_\_\_\_ ft. to \_\_\_\_\_ ft. From \_\_\_\_\_ ft. to \_\_\_\_\_ ft.

6 GROUT MATERIAL:  1 Neat cement     2 Cement grout     3 Bentonite     4 Other \_\_\_\_\_  
 Grout Intervals: From 0 ft. to 2.5 ft. From \_\_\_\_\_ ft. to \_\_\_\_\_ ft. From \_\_\_\_\_ ft. to \_\_\_\_\_ ft.  
 What is the nearest source of possible contamination:  
 1 Septic tank     4 Lateral lines     7 Pit privy     10 Livestock pens     14 Abandoned water well  
 2 Sewer lines     5 Cess pool     8 Sewage lagoon     11 Fuel storage     15 Oil well/Gas well  
 3 Watertight sewer lines     6 Seepage pit     9 Feedyard     12 Fertilizer storage     16 Other (specify below) \_\_\_\_\_  
 13 Insecticide storage \_\_\_\_\_  
 Direction from well? WEST / NORTH WEST How many feet? ~ 200

FROM	TO	LITHOLOGIC LOG	FROM	TO	PLUGGING INTERVALS
0	3	SOIL	90	98	SHALE, GRAY
3	6	SHALE, TAN	98	104	<del>SHALE</del> LIMESTONE, GRAY
6	8	LIMESTONE, TAN	104	108	SHALE, GRAY
8	24	SHALE, GRAY	108	127	SANDSTONE, GRAY
24	42	LIMESTONE, GRAY	127	162	SHALE, GRAY
42	48	SHALE, DK GRAY	162	219	SANDSTONE, GRAY
48	51	LIMESTONE, GRAY	219	222	LIMESTONE, WHITISH TAN
51	59	SHALE, LT. GRAY	222	265	SANDSTONE, GRAY
59	62	LIMESTONE, GRAY	265	270	STANDY SHALE, GRAY
62	67	SHALE, LGT GRAY			TD @ 270
67	81	LIMESTONE, LT. GRAY			
81	83	SHALE, LT. GRAY			
83	85	LIMESTONE, LT. GRAY			
85	87	SHALE, GRAY			
87	90	SANDSTONE, GRAY			

7 CONTRACTOR'S OR LANDOWNER'S CERTIFICATION: This water well was  (1) constructed, (2) reconstructed, or (3) plugged under my jurisdiction and was completed on (mo/day/year) 6/2/99 and this record is true to the best of my knowledge and belief. Kansas Water Well Contractor's License No. SBS This Water Well Record was completed on (mo/day/yr) 6/1/99 under the business name of ASSOC. FAIRFORD, INC. by signature [Signature]

OFFICE USE ONLY T R E W SEC. 1/4 1/4 1/4