WATER WELL RECORD Form WWC-5 KSA 82a-1212 ID No. _____

1 LOCATION OF WATER WELL:	Fraction	Section Number	Township Number	Range Number
County: Franklin	SE ¼ SE ¼ NW ¼	32	T 17 S	R 18 (E)

Distance and direction from nearest town or city street address of well if located within city?
1.25 East and 3.5 North of Williamsburg KS.

2 WATER WELL OWNER: Bobbie Melinda Hubbard
RR#, St. Address, Box # : 535 S. Ash
City, State, ZIP Code : Ottawa, KS. 66067
Board of Agriculture, Division of Water Resources Application Number:

3 LOCATE WELL'S LOCATION WITH AN "X" IN SECTION BOX:

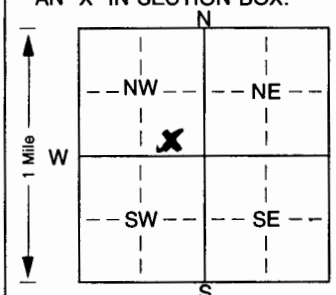

4 DEPTH OF COMPLETED WELL 160 ft. ELEVATION:
Depth(s) Groundwater Encountered 1. 100-144 ft. 2. ft. 3. ft.
WELL'S STATIC WATER LEVEL 99 ft. below land surface measured on mo/day/yr 11-17-00
Pump test data: Well water was ft. after hours pumping gpm
Est. Yield 15 gpm: Well water was ft. after hours pumping gpm
Bore Hole Diameter 8 3/4 in. to 160 ft., and in. to ft.
WELL WATER TO BE USED AS: 5 Public water supply 8 Air conditioning 11 Injection well
(1) Domestic 3 Feedlot 6 Oil field water supply 9 Dewatering 12 Other (Specify below)
2 Irrigation 4 Industrial 7 Domestic (lawn & garden) 10 Monitoring well
Was a chemical/bacteriological sample submitted to Department? Yes No X ; If yes, mo/day/yrs sample was submitted
Water Well Disinfected? Yes X No

5 TYPE OF BLANK CASING USED: 5 Wrought iron 8 Concrete tile CASING JOINTS: Glued X Clamped
1 Steel 3 RMP (SR) 6 Asbestos-Cement 9 Other (specify below) Welded
(2) PVC 4 ABS 7 Fiberglass Threaded
Blank casing diameter 5 in. to 130 ft., Dia 5 in. to 140-160 ft., Dia in. to ft.
Casing height above land surface 24 in., weight SDR 21 200 Class lbs./ft. Wall thickness or gauge No.

TYPE OF SCREEN OR PERFORATION MATERIAL: (7) PVC 10 Asbestos-cement
1 Steel 3 Stainless steel 5 Fiberglass 8 RMP (SR) 11 Other (specify)
2 Brass 4 Galvanized steel 6 Concrete tile 9 ABS 12 None used (open hole)

SCREEN OR PERFORATION OPENINGS ARE: 5 Gauzed wrapped 8 Saw cut 11 None (open hole)
1 Continuous slot (3) Mill slot 25000 6 Wire wrapped 9 Drilled holes
2 Louvered shutter 4 Key punched 7 Torch cut 10 Other (specify) ft.

SCREEN-PERFORATED INTERVALS: From 130 ft. to 140 ft., From ft. to ft.
From ft. to ft., From ft. to ft.
GRAVEL PACK INTERVALS: From 140 ft. to 98 ft., From 92 ft. to 20 ft.
From ft. to ft., From ft. to ft.

6 GROUT MATERIAL: 1 Neat cement 2 Cement grout (3) Bentonite 4 Other
Grout Intervals: From 98 ft. to 92 ft., From 20 ft. to 0 ft., From ft. to ft.
What is the nearest source of possible contamination:
1 Septic tank 4 Lateral lines 7 Pit privy 10 Livestock pens 14 Abandoned water well
2 Sewer lines 5 Cess pool (8) Sewage lagoon 11 Fuel storage 15 Oil well/Gas well
3 Watertight sewer lines 6 Seepage pit 9 Feedyard 12 Fertilizer storage 16 Other (specify below)
13 Insecticide storage
Direction from well? NE How many feet? 150

FROM	TO	LITHOLOGIC LOG	FROM	TO	Lithologic ~~PLUGGING INTERVALS~~ Log Cont
0	6	Soil + Clay	75	96	Shale
6	15	Limestone	96	144	Sandstone
15	31	Shale	144	147	Coal
31	32	Limestone	147	148	Limestone
32	41	Sandy Shale	148	158	Shale
41	45	Limestone	158	160	Limestone
45	49	Sandstone			
49	51	Limestone			
51	54	Sandstone			
54	56	Limestone			
56	58	Sandstone			
58	62	Limestone			
62	73	Shale			
73	75	Coal			

7 CONTRACTOR'S OR LANDOWNER'S CERTIFICATION: This water well was (1) constructed, (2) reconstructed, or (3) plugged under my jurisdiction and was completed on (mo/day/year) 11-17-00 and this record is true to the best of my knowledge and belief. Kansas Water Well Contractor's Licence No. 561 This Water Well Record was completed on (mo/day/yr) 11-22-00 under the business name of Evans Energy Dev. Inc. by (signature) Scott G. Evans

INSTRUCTIONS: Use typewriter or ball point pen. *PLEASE PRESS FIRMLY* and *PRINT* clearly. Please fill in blanks, underline or circle the correct answers. Send top three copies to Kansas Department of Health and Environment, Bureau of Water, Topeka, Kansas 66620-0001. Telephone 785-296-5524. Send one to WATER WELL OWNER and retain one for your records. Fee of $5.00 for each constructed well.