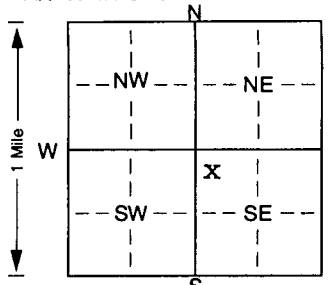


1 LOCATION OF WATER WELL: Fraction NW 1/4 NW 1/4 SE 1/4 Section Number 18 Township Number T 17 S Range Number R 18E EW
 County: Franklin Distance and direction from nearest town or city street address of well if located within city?
 2 3/4 miles south 1/2 mile west of Pamona

2 WATER WELL OWNER: A.J. & Toni Schmidt
 RR#, St. Address, Box #: 2531 California Terr. Board of Agriculture, Division of Water Resources
 City, State, ZIP Code: Pamona, KS. 66076 Application Number:

3 LOCATE WELL'S LOCATION WITH AN "X" IN SECTION BOX:

 4 DEPTH OF COMPLETED WELL: 240 ft. ELEVATION:
 Depth(s) Groundwater Encountered 1 ft. 2 ft. 3 ft.
 WELL'S STATIC WATER LEVEL: 155 ft. below land surface measured on mo/day/yr 7-19-2001
 Pump test data: Well water was ft. after hours pumping gpm
 Est. Yield 4 gpm: Well water was ft. after hours pumping gpm
 Bore Hole Diameter: 8 3/4 in. to ft., and in. to ft.
 WELL WATER TO BE USED AS:
 5 Public water supply 8 Air conditioning 11 Injection well
 1 Domestic 3 Feedlot 6 Oil field water supply 9 Dewatering 12 Other (Specify below)
 2 Irrigation 4 Industrial 7 Domestic (lawn & garden) 10 Monitoring well
 Was a chemical/bacteriological sample submitted to Department? Yes. No. ; If yes, mo/day/yrs sample was submitted Water Well Disinfected? Yes No

5 TYPE OF BLANK CASING USED:
 1 Steel 3 RMP (SR) 5 Wrought iron 8 Concrete tile CASING JOINTS: Glued. Clamped.
 2 PVC 4 ABS 6 Asbestos-Cement 9 Other (specify below) Welded.
 7 Fiberglass Threaded.
 Blank casing diameter 5 in. to ft., Dia in. to ft., Dia in. to ft.
 Casing height above land surface 24 in., weight 2.82 lbs./ft. Wall thickness or gauge No. 258
 TYPE OF SCREEN OR PERFORATION MATERIAL:
 1 Steel 3 Stainless steel 5 Fiberglass 7 PVC 10 Asbestos-cement
 2 Brass 4 Galvanized steel 6 Concrete tile 8 RMP (SR) 11 Other (specify)
 9 ABS 12 None used (open hole)
 SCREEN OR PERFORATION OPENINGS ARE:
 1 Continuous slot 3 Mill slot 5 Gauzed wrapped 8 Saw cut 11 None (open hole)
 2 Louvered shutter 4 Key punched 6 Wire wrapped 9 Drilled holes
 7 Torch cut 10 Other (specify) ft.
 SCREEN-PERFORATED INTERVALS: From 160 ft. to 180 ft., From 200 ft. to 240 ft., From 24 ft. to 240 ft., From ft. to ft.
 GRAVEL PACK INTERVALS: From 24 ft. to 240 ft., From ft. to ft., From ft. to ft.

6 GROUT MATERIAL: 1 Neat cement 2 Cement grout 3 Bentonite 4 Other
 Grout Intervals: From 4 ft. to 24 ft., From ft. to ft., From ft. to ft.
 What is the nearest source of possible contamination:
 1 Septic tank 4 Lateral lines 7 Pit privy 10 Livestock pens 14 Abandoned water well
 2 Sewer lines 5 Cess pool 8 Sewage lagoon 11 Fuel storage 15 Oil well/Gas well
 3 Watertight sewer lines 6 Seepage pit 9 Feedyard 12 Fertilizer storage 16 Other (specify below)
 13 Insecticide storage
 Direction from well? East How many feet? 160

FROM	TO	LITHOLOGIC LOG	FROM	TO	PLUGGING INTERVALS
0	1	top soil	92	94	grey shale
1	3	brown clay	94	99	grey limestone
3	11	tan limestone	99	105	grey shaly limestone
11	18	black shale	105	111	black shale
18	19	grey flinty limestone	111	112	grey sandrock
19	25	grey shale	112	130	grey shale
25	29	grey limestone	130	138	grey shaly limestone
29	31	grey shale	138	140	grey sandstone
31	51	tan flinty limestone	140	147	grey shale
51	62	grey shale	147	183	grey sandstone
62	66	grey limestone	183	187	grey limestone
66	75	grey shale	187	190	grey shale
75	91	grey sandrock	190	191	grey limestone
91	92	grey limestone	191	204	grey shaly limestone

7 CONTRACTOR'S OR LANDOWNER'S CERTIFICATION: This water well was (1) constructed, (2) reconstructed, or (3) plugged under my jurisdiction and was completed on (mo/day/year) 7-18-2001 and this record is true to the best of my knowledge and belief. Kansas Water Well Contractor's Licence No. 182 This Water Well Record was completed on (mo/day/yr) 7-25-2001 under the business name of Strader Drilling Co., Inc. by (signature) Dale Strader