


1 LOCATION OF WATER WELL: County: Franklin Fraction: SW 1/4 NW 1/4 SE 1/4 Section Number: 18 Township Number: T 17 S Range Number: R 18 E

Distance and direction from nearest town or city street address of well if located within city?
2.7 miles South of 68 + .45 West of Colorado Rd.

2 WATER WELL OWNER: Howard + Connie Darr
 RR#, St. Address, Box #: 2567 Colorado Terrace Board of Agriculture, Division of Water Resources
 City, State, ZIP Code: Pomona, ks. 66076 Application Number:

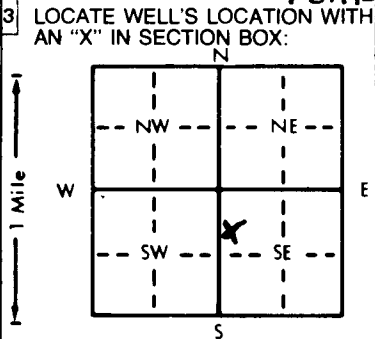

4 DEPTH OF COMPLETED WELL: 250 ft. ELEVATION: ft.
 Depth(s) Groundwater Encountered 1. 170-245 ft. 2. ft. 3. ft.
 WELL'S STATIC WATER LEVEL: 160 ft. below land surface measured on mo/day/yr 8-26-98
 Pump test data: Well water was ft. after hours pumping gpm
 Est. Yield 12 gpm; Well water was ft. after hours pumping gpm
 Bore Hole Diameter 8 3/4 in. to 250 ft. and in. to ft.
 WELL WATER TO BE USED AS:
 5 Public water supply 8 Air conditioning 11 Injection well
 1 Domestic 3 Feedlot 6 Oil field water supply 9 Dewatering 12 Other (Specify below)
 2 Irrigation 4 Industrial 7 Lawn and garden only 10 Monitoring well
 Was a chemical/bacteriological sample submitted to Department? Yes No Y; If yes, mo/day/yr sample was submitted
 Water Well Disinfected? Yes X No

5 TYPE OF BLANK CASING USED:
 1 Steel 3 RMP (SR) 5 Wrought iron 8 Concrete tile CASING JOINTS: Glued X Clamped
 2 PVC 4 ABS 6 Asbestos-Cement 9 Other (specify below) Welded
 7 Fiberglass Threaded
 Blank casing diameter 5 in. to 240 ft. Dia in. to ft. Dia in. to ft.
 Casing height above land surface: 24 in. weight SDR21 lbs./ft. Wall thickness or gauge No.
 TYPE OF SCREEN OR PERFORATION MATERIAL:
 1 Steel 3 Stainless steel 5 Fiberglass 7 PVC 10 Asbestos-cement
 2 Brass 4 Galvanized steel 6 Concrete tile 9 ABS 11 Other (specify)
 12 None used (open hole)
 SCREEN OR PERFORATION OPENINGS ARE:
 1 Continuous slot 3 Mill slot 30,000 5 Gauzed wrapped 8 Saw cut 11 None (open hole)
 2 Louvered shutter 4 Key punched 6 Wire wrapped 9 Drilled holes
 7 Torch cut 10 Other (specify)
 SCREEN-PERFORATED INTERVALS: From 240 ft. to 250 ft. From ft. to ft.
 GRAVEL PACK INTERVALS: From 250 ft. to 140 ft. From ft. to ft.
 From 130 ft. to 20 ft. From ft. to ft.

6 GROUT MATERIAL: 1 Neat cement 2 Cement grout 3 Bentonite 4 Other
 Grout Intervals: From 140 ft. to 130 ft. From 20 ft. to 0 ft. From ft. to ft.
 What is the nearest source of possible contamination:
 1 Septic tank 4 Lateral lines 7 Pit privy 10 Livestock pens 14 Abandoned water well
 2 Sewer lines 5 Cess pool 8 Sewage lagoon 11 Fuel storage 15 Oil well/Gas well
 3 Watertight sewer lines 6 Seepage pit 9 Feedyard 12 Fertilizer storage 16 Other (specify below)
 13 Insecticide storage
 Direction from well? E How many feet? 150

FROM	TO	LITHOLOGIC LOG	FROM	TO	PLUGGING INTERVALS
0	3	Soil + Clay	245	250	Log Shale
3	8	Limestone			
8	14	Shale			
14	17	Limestone			
17	23	Shale			
23	25	Limestone			
25	30	shale			
30	45	Limestone			
45	47	Sand + shale - grey			
47	58	shale			
58	61	Limestone			
61	67	Sandy Limestone			
67	75	Limestone			
75	138	SANDY shale			
138	245	SANDstone - white			

7 CONTRACTOR'S OR LANDOWNER'S CERTIFICATION: This water well was (1) constructed, (2) reconstructed, or (3) plugged under my jurisdiction and was completed on (mo/day/year) 8-26-98 and this record is true to the best of my knowledge and belief. Kansas Water Well Contractor's License No. 561 This Water Well Record was completed on (mo/day/yr) 8-27-98 under the business name of EVANS Energy Development Inc. by (signature) [Signature]

OFFICE USE ONLY

T

R

EW

SEC

1/4

1/4

1/4