

County: Franklin Fraction: SW SE SE SE Sec. 18 T 17 S R 18 E

**CORRECTION(S) TO WATER WELL COMPLETION RECORD Form WWC-5 (to rectify lacking or incorrect information)**

Owner: Zach Williams

If location corrected, was listed as:

Location changed to:

Section-Township-Range: 18-17S-18E

18-17S-18E

Fraction (1/4 calls): None Given

SW SE SE SE

Other changes: Initial statements: 4 miles South and 1/4 West of Pomona.

Changed to: From Pomona: 3 mi. S. and 0.12 mi. W.

Comments: \_\_\_\_\_

Verification method: Written & legal descriptions, Franklin County online parcel search, and KGS' online mapping tool & aerial photos, and original constructed record. Initials: DRR Date: 12/4/2018

Submitted by:  Kansas Geological Survey, Data Resources Library, 1930 Constant Avenue, Lawrence, KS 66047-3724  
 Kansas Dept. of Health & Environment, Bureau of Water, 1000 SW Jackson, Suite 420, Topeka, KS 66612-1367

WATER WELL RECORD

Form WWC-5


Division of Water Resources App. No.

[Empty box]

1 LOCATION OF WATER WELL: County: FRANKLIN Fraction 1/4 1/4 1/4 1/4 Section Number 18 Township No. T 17 S Range Number R 18 [X] E [ ] W

Street/Rural Address of Well Location; if unknown, distance & direction from nearest town or intersection: 4 miles South and 44 West of Pomona Global Positioning System (GPS) information: Latitude: Longitude: Elevation: Datum: Collection Method: Est. Accuracy:

2 WATER WELL OWNER: ZACH WILSON RR#, Street Address, Box #: 679 Kingman Rd City, State, ZIP Code: Pomona, KS 66076

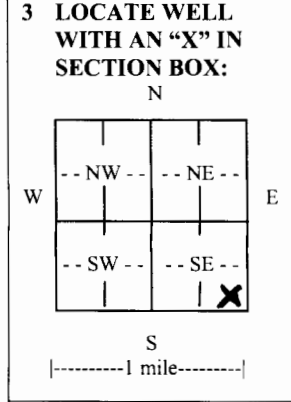

3 LOCATE WELL WITH AN 'X' IN SECTION BOX: 4 DEPTH OF COMPLETED WELL 250 ft. Depth(s) Groundwater Encountered (1) 160' ft. (2) ft. (3) ft. WELL'S STATIC WATER LEVEL 160' ft. below land surface measured on mo/day/yr. 8-21-17 Pump test data: EST. YIELD: Bore Hole Diameter: WELL WATER TO BE USED AS: [X] Domestic [ ] Feedlot [ ] Oil field water supply [ ] Dewatering [ ] Other (Specify below) [ ] Irrigation [ ] Industrial [ ] Domestic-lawn & garden [ ] Monitoring well Was a chemical/bacteriological sample submitted to Department? [ ] Yes [X] No If yes, mo/day/yr sample was submitted: Water well disinfected? [X] Yes [ ] No

5 TYPE OF CASING USED: [ ] Steel [X] PVC [ ] Other CASING JOINTS: [ ] Glued [ ] Clamped [ ] Welded [ ] Threaded Casing diameter 5" in. to ft., Diameter in. to ft., Diameter in. to ft. Casing height above land surface below 4' in., Weight lbs./ft., Wall thickness or gauge No. TYPE OF SCREEN OR PERFORATION MATERIAL: [ ] Steel [ ] Stainless Steel [ ] PVC [ ] Other (Specify) [ ] Brass [ ] Galvanized Steel [ ] None used (open hole) SCREEN OR PERFORATION OPENINGS ARE: [ ] Continuous slot [ ] Mill slot [ ] Gauze wrapped [ ] Torch cut [ ] Drilled holes [ ] None (open hole) [ ] Louvered shutter [ ] Key punched [ ] Wire wrapped [ ] Saw cut [ ] Other (specify) SCREEN-PERFORATED INTERVALS: GRAVEL PACK INTERVALS:

6 GROUT MATERIAL: [ ] Neat cement [ ] Cement grout [X] Bentonite [ ] Other Grout Intervals: From 250 ft. to 4 ft., From ft. to ft., From ft. to ft. What is the nearest source of possible contamination: [ ] Septic tank [ ] Lateral lines [ ] Pit privy [X] Livestock pens [ ] Insecticide storage [ ] Other (specify below) [ ] Sewer lines [ ] Cesspool [ ] Sewage lagoon [ ] Fuel storage [ ] Abandoned water well [ ] Watertight sewer lines [ ] Seepage pit [ ] Feedyard [ ] Fertilizer storage [ ] Oil well/gas well Direction from well NORTH Distance from well 30'

Table with 6 columns: FROM, TO, LITHOLOGIC LOG, FROM, TO, LITHO. LOG (cont.) or PLUGGING INTERVALS. Row 1: 250-4' - Bentonite. Row 2: 4-0

7 CONTRACTOR'S OR LANDOWNER'S CERTIFICATION: This water well was [ ] constructed, [ ] reconstructed, or [X] plugged under my jurisdiction and was completed on (mo/day/year) 8-21-17 and this record is true to the best of my knowledge and belief. Kansas Water Well Contractor's License No. 536 This Water Well Record was completed on (mo/day/year) 8-23-2017 under the business name of Pritchard Pump & Well Drilling, Inc. by (signature) Tom Pritchard INSTRUCTIONS: Use typewriter or ball point pen. PLEASE PRESS FIRMLY and PRINT clearly. Please fill in blanks and check the correct answers. Send three copies (white, blue, pink) to Kansas Department of Health and Environment, Bureau of Water, Geology Section, 1000 SW Jackson St., Suite 420, Topeka, Kansas 66612-1367. Telephone 785-296-5524. Send one copy to WATER WELL OWNER and retain one for your records. Include fee of \$5.00 for each constructed well. Visit us at http://www.kdheks.gov/waterwell/index.html.