

WATER WELL RECORD Form WWC-5

Division of Water Resources App. No. _____

Well ID **MW-5**

Original Record Correction Change in Well Use

1 LOCATION OF WATER WELL: County: Franklin Fraction: SW 1/4 NW 1/4 NE 1/4 SE 1/4 Section Number: 11 Township Number: T 17 S Range Number: R 18 E

2 WELL OWNER: Last Name: _____ First: _____
 Business: Franklin County
 Address: 1901 S. Elm Street
 Address: _____
 City: Ottawa State: KS ZIP: 66067
 Street or Rural Address where well is located (if unknown, distance and direction from nearest town or intersection): If at owner's address, check here:

3 LOCATE WELL WITH "X" IN SECTION BOX:
 N

-- NW --	-- NE --	
W	X	E
-- SW --	-- SE --	

 S
 [-----1 mile-----]

4 DEPTH OF COMPLETED WELL: ... 26.97 ... ft.
 Depth(s) Groundwater Encountered: 1) ... 19.71 ... ft.
 2) ... ft. 3) ... ft. or 4) Dry Well
 WELL'S STATIC WATER LEVEL: ... ft.
 below land surface, measured on (mo-day-yr) ... 12-31-19 ...
 above land surface, measured on (mo-day-yr) ...
 Pump test data: Well water was ... ft.
 after ... hours pumping ... gpm
 Well water was ... ft.
 after ... hours pumping ... gpm
 Estimated Yield: ... gpm
 Bore Hole Diameter: ... 8.0 ... in. to ... ft. and ... in. to ... ft.

5 Latitude: ... 38.585658 ... (decimal degrees)
Longitude: ... 95.272308 ... (decimal degrees)
Horizontal Datum: WGS 84 NAD 83 NAD 27
Source for Latitude/Longitude:
 GPS (unit make/model: ...)
 (WAAS enabled? Yes No)
 Land Survey Topographic Map
 Online Mapper: Google Earth
6 Elevation: 946 ... ft. Ground Level TOC
Source: Land Survey GPS Topographic Map
 Other Google Earth

7 WELL WATER TO BE USED AS:

1. Domestic: <input type="checkbox"/> Household <input type="checkbox"/> Lawn & Garden <input type="checkbox"/> Livestock	5. <input type="checkbox"/> Public Water Supply: well ID _____	10. <input type="checkbox"/> Oil Field Water Supply: lease _____
2. <input type="checkbox"/> Irrigation	6. <input type="checkbox"/> Dewatering: how many wells? _____	11. Test Hole: well ID _____ <input type="checkbox"/> Cased <input type="checkbox"/> Uncased <input type="checkbox"/> Geotechnical
3. <input type="checkbox"/> Feedlot	7. <input type="checkbox"/> Aquifer Recharge: well ID _____	12. Geothermal: how many bores? _____ a) Closed Loop <input type="checkbox"/> Horizontal <input type="checkbox"/> Vertical b) Open Loop <input type="checkbox"/> Surface Discharge <input type="checkbox"/> Inj. of Water
4. <input type="checkbox"/> Industrial	8. <input checked="" type="checkbox"/> Monitoring: well ID <u>MW-5</u>	13. <input type="checkbox"/> Other (specify): _____
	9. Environmental Remediation: well ID _____ <input type="checkbox"/> Air Sparge <input type="checkbox"/> Soil Vapor Extraction <input type="checkbox"/> Recovery <input type="checkbox"/> Injection	


Was a chemical/bacteriological sample submitted to KDHE? Yes No If yes, date sample was submitted: _____
 Water well disinfected? Yes No

8 TYPE OF CASING USED: Steel PVC Other _____ CASING JOINTS: Glued Clamped Welded Threaded
 Casing diameter ... 2.0 ... in. to ... 11.97 ... ft., Diameter ... in. to ... ft., Diameter ... in. to ... ft.
 Casing height above land surface ... 24 ... in. Weight ... lbs./ft. Wall thickness or gauge No. Sch. 40
TYPE OF SCREEN OR PERFORATION MATERIAL:
 Steel Stainless Steel Fiberglass PVC Other (Specify) _____
 Brass Galvanized Steel Concrete tile None used (open hole)
SCREEN OR PERFORATION OPENINGS ARE:
 Continuous Slot Mill Slot Gauze Wrapped Torch Cut Drilled Holes Other (Specify) _____
 Louvered Shutter Key Punched Wire Wrapped Saw Cut None (Open Hole)
SCREEN-PERFORATED INTERVALS: From ... 11.97 ... ft. to ... 26.97 ... ft., From ... ft. to ... ft., From ... ft. to ... ft.
GRAVEL PACK INTERVALS: From ... 9 ... ft. to ... 26.97 ... ft., From ... ft. to ... ft., From ... ft. to ... ft.

9 GROUT MATERIAL: Neat cement Cement grout Bentonite Other _____
 Grout Intervals: From ... 0 ... ft. to ... 1 ... ft., From ... 1 ... ft. to ... 9 ... ft., From ... ft. to ... ft.
Nearest source of possible contamination:
 Septic Tank Lateral Lines Pit Privy Livestock Pens Insecticide Storage
 Sewer Lines Cess Pool Sewage Lagoon Fuel Storage Abandoned Water Well
 Watertight Sewer Lines Seepage Pit Feedyard Fertilizer Storage Oil Well/Gas Well
 Other (Specify) _____
 Direction from well? Southwest Distance from well? .87 ... ft.

10 FROM	TO	LITHOLOGIC LOG	FROM	TO	LITHO. LOG (cont.) or PLUGGING INTERVALS
0	3	Silty fill			
3	3	Silt with minor clay			
3	8	Silty with clay			
8	15	Silty clay			
15	26.97	Silt with minor clay			
Notes: Stick up completion					

11 CONTRACTOR'S OR LANDOWNER'S CERTIFICATION: This water well was constructed, reconstructed, or plugged under my jurisdiction and was completed on (mo-day-year) 11/18/19 and this record is true to the best of my knowledge and belief. Kansas Water Well Contractor's License No. 650 This Water Well Record was completed on (mo-day-year) 2/16/20 under the business name of K&T Signature [Signature]

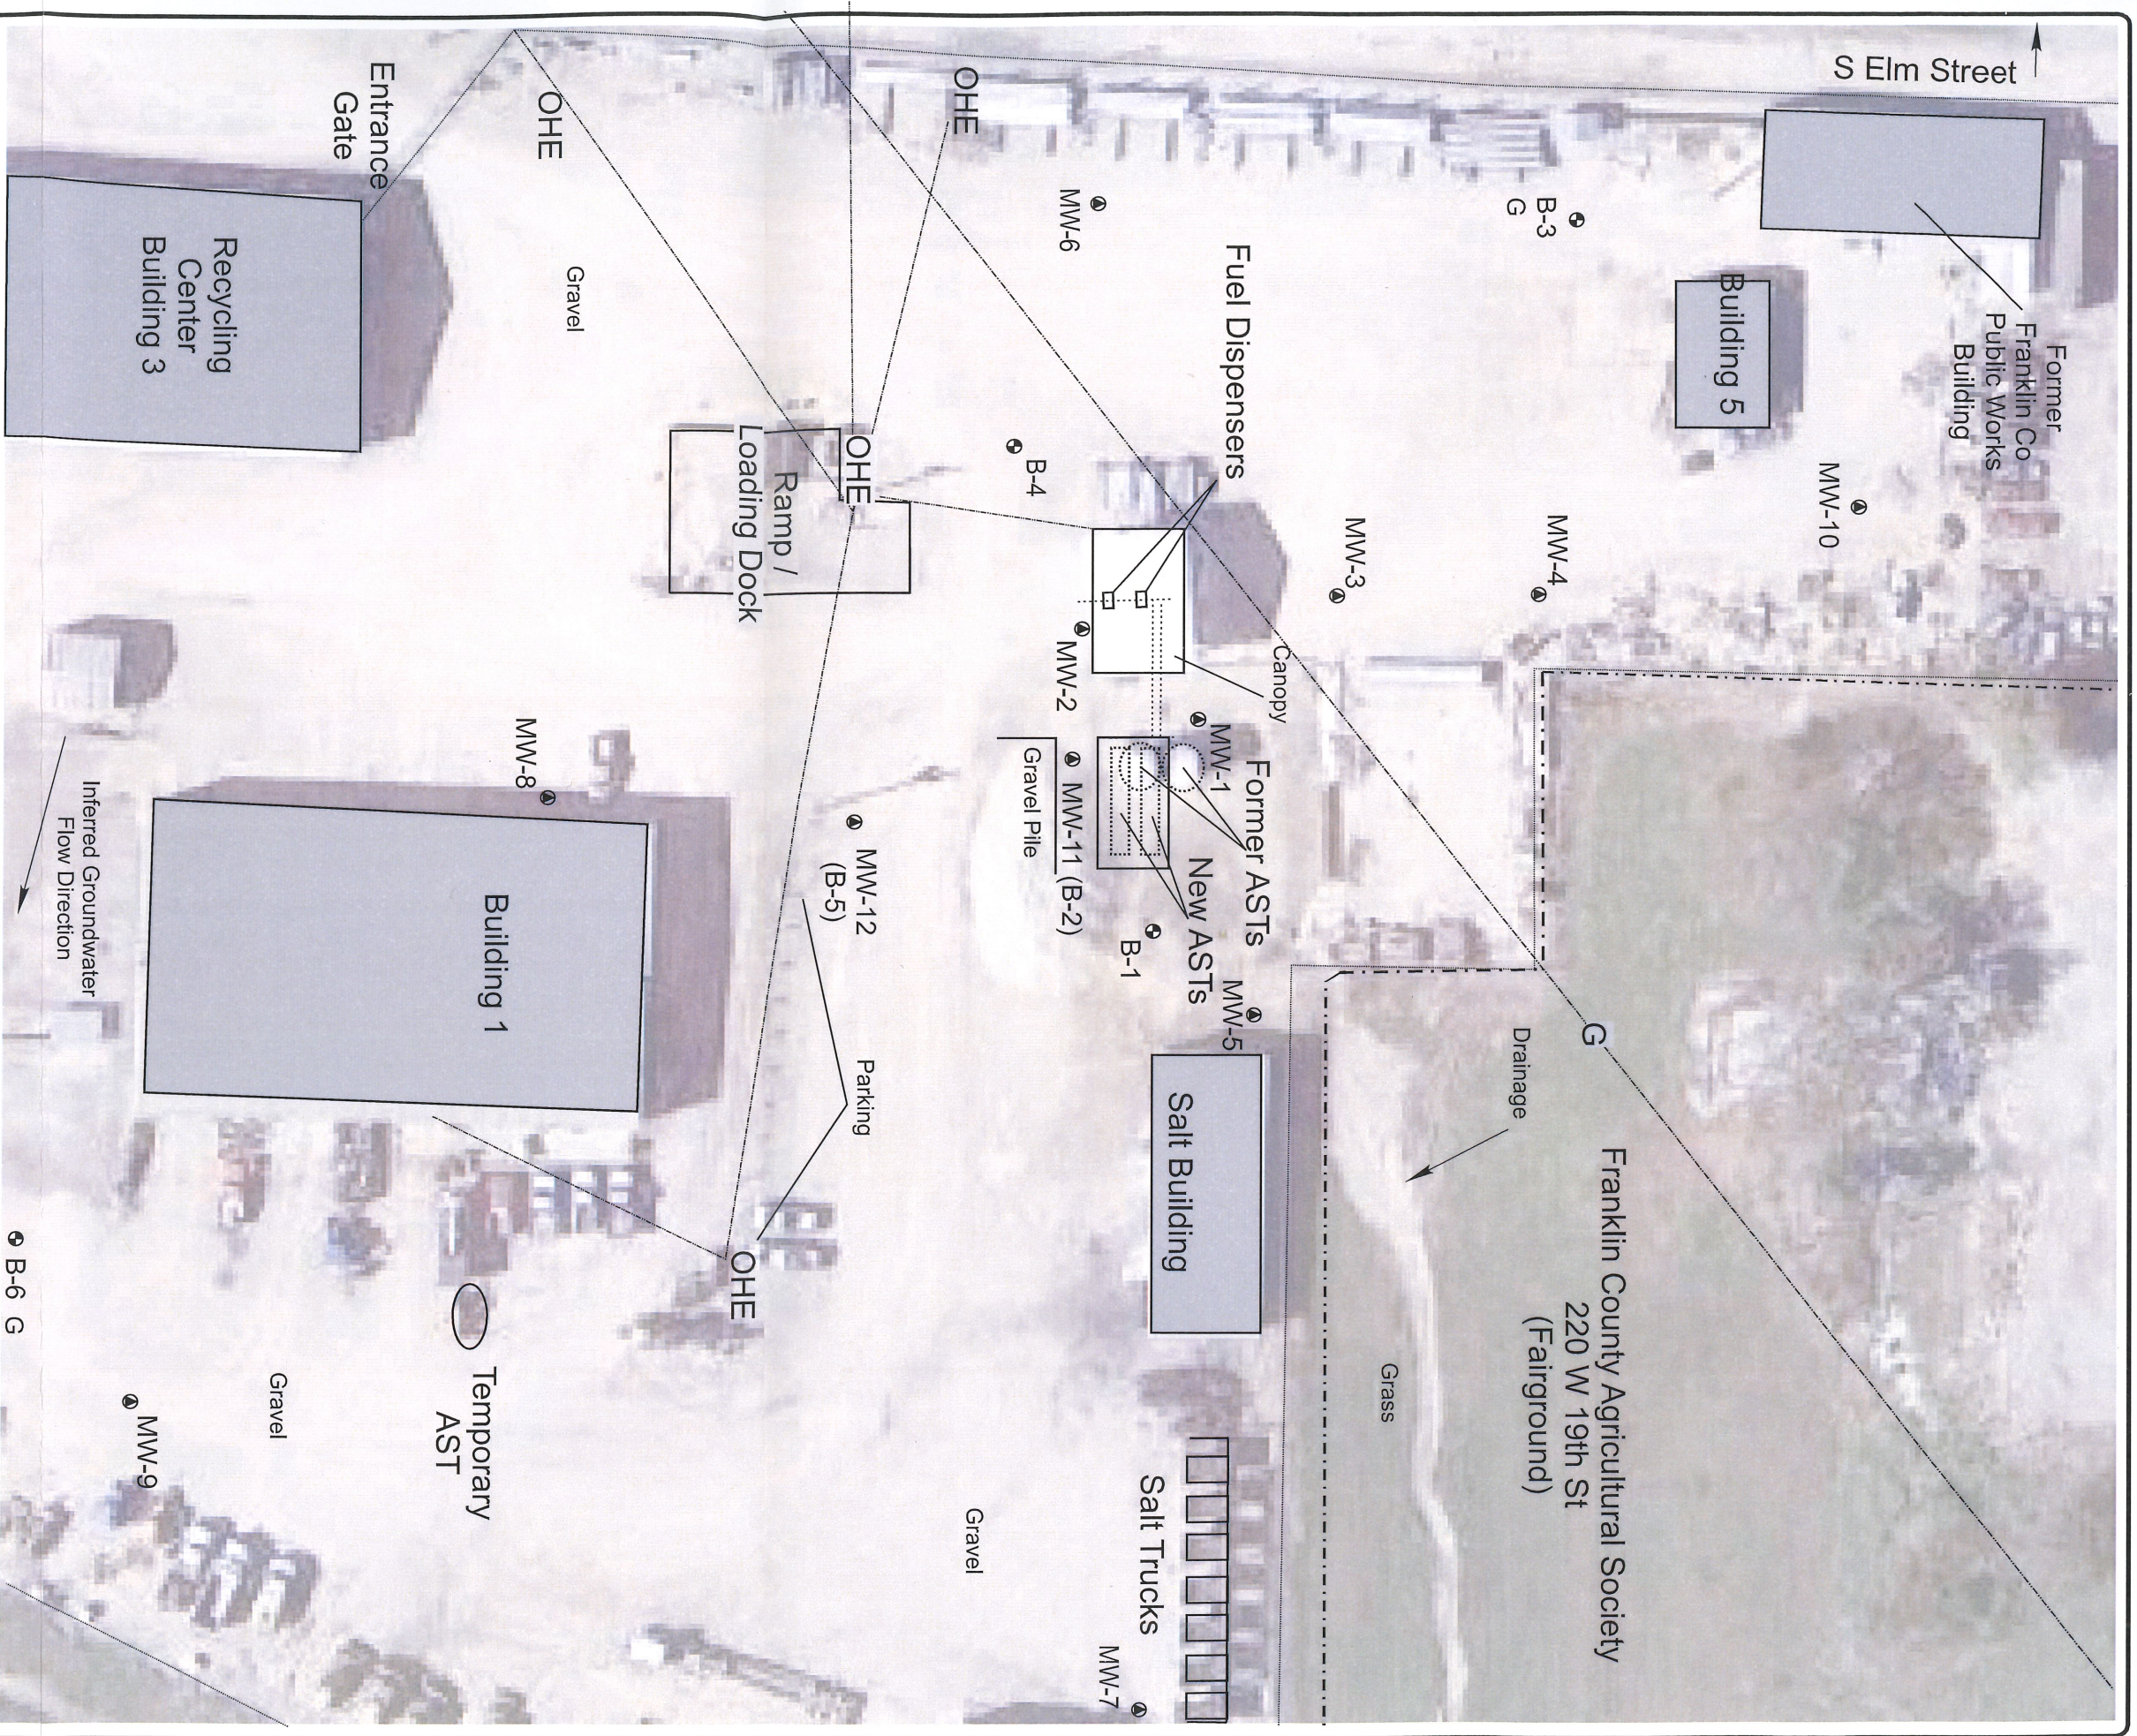

- Notes:
- Monitoring Well
 - Soil Boring Location (borings denoted with (G) for hydrologic samples)
 - AST Location
 - ⋯ Product Line Location
 - - - Property Boundary
 - Fence
 - 🌳 Tree (approx.)
 - Ⓜ Buried Gas Line (3' - 5' depth, approx.)
 - OHE Overhead Electric, Cable, & Telephone Line (15' ave height, approx.)


Source: Google Earth
 Date of Aerial Photograph: 10/16



Knightly Environmental Incorporated
 Lenexa, Kansas

KEI Job No.: 69-061903-60
 Date: 01/14/20

Figure 2

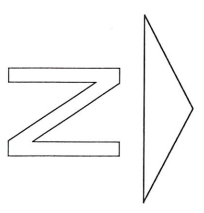

Note: Scale Approximate

Franklin County
 1901 S Elm
 Ottawa, Kansas
 KDHE Project: A4-030-40493

Site Map