

WATER WELL RECORD Form WWC-5

Original Record Correction Change in Well Use

Division of Water Resources App. No.

Well ID MW-11

1 LOCATION OF WATER WELL: County: Franklin	Fraction SW ¼ NW ¼ NE ¼ SE ¼	Section Number 11	Township Number T 17 S	Range Number R 18 <input checked="" type="checkbox"/> E <input type="checkbox"/> W
2 WELL OWNER: Last Name: Franklin County Business: Franklin County Address: 1901 S. Elm Street Address: City: Ottawa State: KS ZIP: 66067		Street or Rural Address where well is located (if unknown, distance and direction from nearest town or intersection): If at owner's address, check here: <input type="checkbox"/>		

<p>3 LOCATE WELL WITH "X" IN SECTION BOX:</p> <p style="text-align: center;">N</p> <table border="1" style="margin: auto; border-collapse: collapse;"> <tr> <td style="padding: 5px;">-- NW --</td> <td style="padding: 5px;">-- NE --</td> </tr> <tr> <td style="padding: 5px;">W</td> <td style="padding: 5px;">E</td> </tr> <tr> <td style="padding: 5px;">-- SW --</td> <td style="padding: 5px;">-- SE --</td> </tr> <tr> <td colspan="2" style="text-align: center; padding: 5px;">S</td> </tr> </table> <p style="text-align: center;">----- 1 mile -----</p>	-- NW --	-- NE --	W	E	-- SW --	-- SE --	S		<p>4 DEPTH OF COMPLETED WELL: ... 23.77... ft.</p> <p>Depth(s) Groundwater Encountered: 1) ... 15.70... ft. 2) ft. 3) ft., or 4) <input type="checkbox"/> Dry Well</p> <p>WELL'S STATIC WATER LEVEL: ft.</p> <p><input type="checkbox"/> below land surface, measured on (mo-day-yr)... 12-31-19. <input type="checkbox"/> above land surface, measured on (mo-day-yr).....</p> <p>Pump test data: Well water was ft. after..... hours pumping gpm Well water was ft. after..... hours pumping gpm</p> <p>Estimated Yield: gpm Bore Hole Diameter: ... 8.0... in. to ft. and in. to ft.</p>	<p>5 Latitude: 38.585483..... (decimal degree) Longitude: 95.272486..... (decimal degree) Horizontal Datum: <input checked="" type="checkbox"/> WGS 84 <input type="checkbox"/> NAD 83 <input type="checkbox"/> NAD 27 Source for Latitude/Longitude: <input type="checkbox"/> GPS (unit make/model:) (WAAS enabled? <input type="checkbox"/> Yes <input type="checkbox"/> No) <input type="checkbox"/> Land Survey <input type="checkbox"/> Topographic Map <input checked="" type="checkbox"/> Online Mapper: Google Earth.....</p>													
-- NW --	-- NE --																						
W	E																						
-- SW --	-- SE --																						
S																							
<p>7 WELL WATER TO BE USED AS:</p> <table style="width: 100%;"> <tr> <td style="width: 33%;">1. Domestic: <input type="checkbox"/> Household <input type="checkbox"/> Lawn & Garden <input type="checkbox"/> Livestock</td> <td style="width: 33%;">5. <input type="checkbox"/> Public Water Supply: well ID</td> <td style="width: 33%;">10. <input type="checkbox"/> Oil Field Water Supply: lease</td> </tr> <tr> <td>2. <input type="checkbox"/> Irrigation</td> <td>6. <input type="checkbox"/> Dewatering: how many wells?</td> <td>11. Test Hole: well ID</td> </tr> <tr> <td>3. <input type="checkbox"/> Feedlot</td> <td>7. <input type="checkbox"/> Aquifer Recharge: well ID</td> <td><input type="checkbox"/> Cased <input type="checkbox"/> Uncased <input type="checkbox"/> Geotechnical</td> </tr> <tr> <td>4. <input type="checkbox"/> Industrial</td> <td>8. <input checked="" type="checkbox"/> Monitoring: well ID MW-11</td> <td>12. Geothermal: how many bores?</td> </tr> <tr> <td></td> <td>9. Environmental Remediation: well ID</td> <td>a) Closed Loop <input type="checkbox"/> Horizontal <input type="checkbox"/> Vertical</td> </tr> <tr> <td></td> <td><input type="checkbox"/> Air Sparge <input type="checkbox"/> Soil Vapor Extraction</td> <td>b) Open Loop <input type="checkbox"/> Surface Discharge <input type="checkbox"/> Inj. of Water</td> </tr> <tr> <td></td> <td><input type="checkbox"/> Recovery <input type="checkbox"/> Injection</td> <td>13. <input type="checkbox"/> Other (specify):</td> </tr> </table>		1. Domestic: <input type="checkbox"/> Household <input type="checkbox"/> Lawn & Garden <input type="checkbox"/> Livestock	5. <input type="checkbox"/> Public Water Supply: well ID	10. <input type="checkbox"/> Oil Field Water Supply: lease	2. <input type="checkbox"/> Irrigation	6. <input type="checkbox"/> Dewatering: how many wells?	11. Test Hole: well ID	3. <input type="checkbox"/> Feedlot	7. <input type="checkbox"/> Aquifer Recharge: well ID	<input type="checkbox"/> Cased <input type="checkbox"/> Uncased <input type="checkbox"/> Geotechnical	4. <input type="checkbox"/> Industrial	8. <input checked="" type="checkbox"/> Monitoring: well ID MW-11	12. Geothermal: how many bores?		9. Environmental Remediation: well ID	a) Closed Loop <input type="checkbox"/> Horizontal <input type="checkbox"/> Vertical		<input type="checkbox"/> Air Sparge <input type="checkbox"/> Soil Vapor Extraction	b) Open Loop <input type="checkbox"/> Surface Discharge <input type="checkbox"/> Inj. of Water		<input type="checkbox"/> Recovery <input type="checkbox"/> Injection	13. <input type="checkbox"/> Other (specify):	<p>6 Elevation: 947..... ft. <input checked="" type="checkbox"/> Ground Level <input type="checkbox"/> TOC Source: <input type="checkbox"/> Land Survey <input type="checkbox"/> GPS <input type="checkbox"/> Topographic Map <input checked="" type="checkbox"/> Other Google Earth.....</p>

Was a chemical/bacteriological sample submitted to KDHE? Yes No If yes, date sample was submitted:

Water well disinfected? Yes No

8 TYPE OF CASING USED: Steel PVC Other CASING JOINTS: Glued Clamped Welded Threaded

Casing diameter 2.0... in. to 8.77... ft., Diameter in. to ft., Diameter in. to ft.

Casing height above land surface Flush... in. Weight lbs./ft. Wall thickness or gauge No. Sch. 40.....

TYPE OF SCREEN OR PERFORATION MATERIAL:
 Steel Stainless Steel Fiberglass PVC Other (Specify)

Brass Galvanized Steel Concrete tile None used (open hole)

SCREEN OR PERFORATION OPENINGS ARE:
 Continuous Slot Mill Slot Gauze Wrapped Torch Cut Drilled Holes Other (Specify)

Louvered Shutter Key Punched Wire Wrapped Saw Cut None (Open Hole)

SCREEN-PERFORATED INTERVALS: From .8.77... ft. to 23.77... ft., From ft. to ft., From ft. to ft.

GRAVEL PACK INTERVALS: From 7... ft. to 23.77... ft., From ft. to ft., From ft. to ft.

9 GROUT MATERIAL: Neat cement Cement grout Bentonite Other

Grout Intervals: From 0... ft. to 1... ft., From 1... ft. to 7... ft., From ft. to ft.

Nearest source of possible contamination:

<input type="checkbox"/> Septic Tank	<input type="checkbox"/> Lateral Lines	<input type="checkbox"/> Pit Privy	<input type="checkbox"/> Livestock Pens	<input type="checkbox"/> Insecticide Storage
<input type="checkbox"/> Sewer Lines	<input type="checkbox"/> Cess Pool	<input type="checkbox"/> Sewage Lagoon	<input checked="" type="checkbox"/> Fuel Storage	<input type="checkbox"/> Abandoned Water Well
<input type="checkbox"/> Watertight Sewer Lines	<input type="checkbox"/> Seepage Pit	<input type="checkbox"/> Feedyard	<input type="checkbox"/> Fertilizer Storage	<input type="checkbox"/> Oil Well/Gas Well
<input type="checkbox"/> Other (Specify)				


Direction from well? Northwest..... Distance from well? 50..... ft.

10 FROM	TO	LITHOLOGIC LOG	FROM	TO	LITHO. LOG (cont.) or PLUGGING INTERVALS
0	1	Silty topsoil			
1	8	Silty clay			
8	11	Silt with clay			
11	17	Silty clay			
17	23.77	Silt with clay			
Notes:					

11 CONTRACTOR'S OR LANDOWNER'S CERTIFICATION: This water well was constructed, reconstructed, or plugged under my jurisdiction and was completed on (mo-day-yr) 11/18/19..... and this record is true to the best of my knowledge and belief. Kansas Water Well Contractor's License No. 650..... This Water Well Record was completed on (mo-day-yr) 2/6/20..... under the business name of L.C.T. Signature [Signature]

Mail 1 white copy along with a fee of \$5.00 for each constructed well to: Kansas Department of Health and Environment, Bureau of Water, GWTS Section, 1000 SW Jackson St., Suite 420, Topeka, Kansas 66612-1367. Mail one to Water Well Owner and retain one for your records. Telephone 785-296-5524.


Visit us at <http://www.kdheks.gov/waterwell/index.html> KSA 82a-1212 Revised 7/10/2015

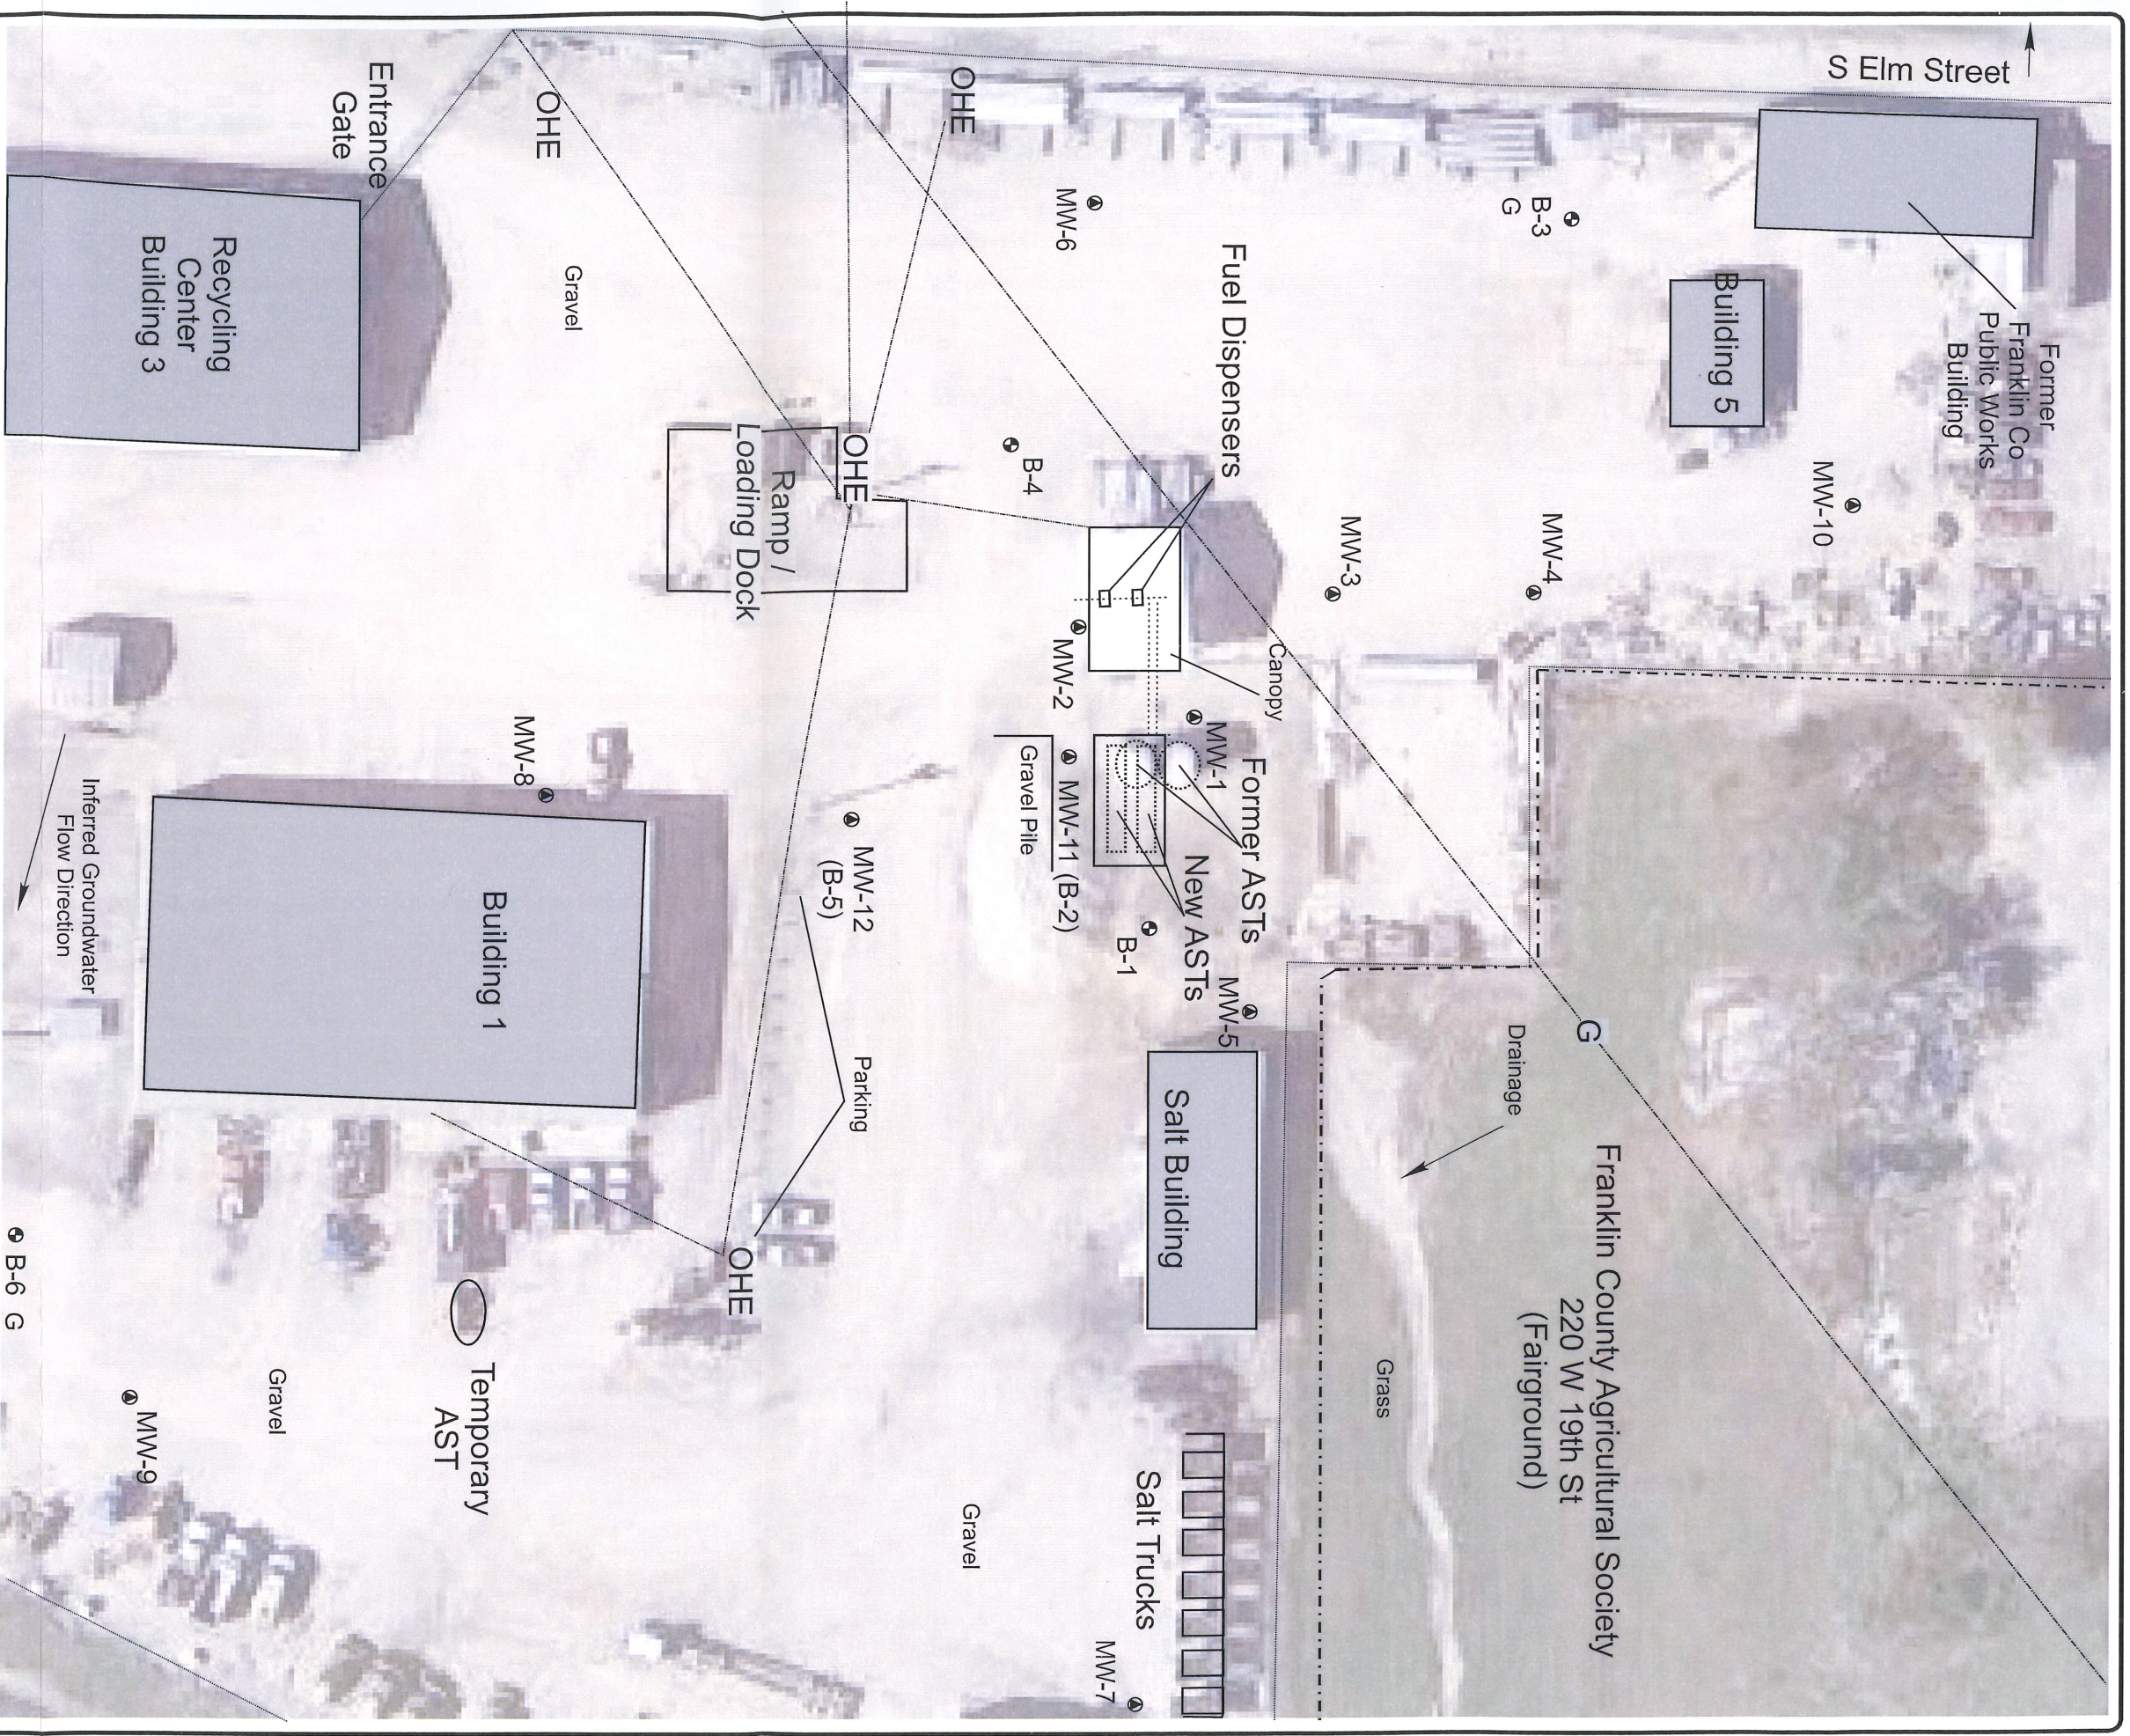


Notes:


- Monitoring Well
- Soil Boring Location (borings denoted with (G) for hydrologic samples)
- AST Location
- ⋯ Product Line Location
- - - Property Boundary
- Fence
- 🌳 Tree (approx.)
- Ⓜ Buried Gas Line (3' - 5' depth, approx.)
- OHE Overhead Electric, Cable, & Telephone Line (15' ave height, approx.)

Source: Google Earth
 Date of Aerial Photograph: 10/16


 Knightly Environmental Incorporated
 Lenexa, Kansas

KEI Job No.: 69-061903-60
 Date: 01/14/20





 Note: Scale Approximate

Figure 2
 Franklin County
 1901 S Elm
 Ottawa, Kansas
 KDHE Project: A4-030-40493
Site Map