


1 LOCATION OF WATER WELL: County: Franklin Fraction: NW 1/4 SE 1/4 SE 1/4 Section Number: 12 Township Number: T 17 S Range Number: R 18 E

Distance and direction from nearest town or city street address of well if located within city?  
1592 Labette Road OTTAWA, KANSAS 66067

2 WATER WELL OWNER: Jim Gilliland  
 RR#, St. Address, Box #: 1671 Labette Drive Board of Agriculture, Division of Water Resources  
 City, State, ZIP Code: OTTAWA, KS. 66067 Application Number:

3 LOCATE WELL'S LOCATION WITH AN "X" IN SECTION BOX:

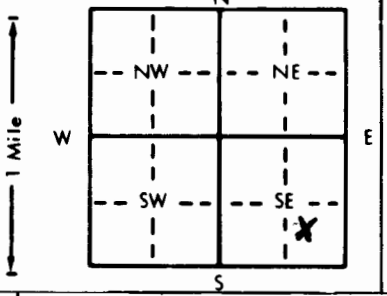

4 DEPTH OF COMPLETED WELL: 68 ft. ELEVATION:

Depth(s) Groundwater Encountered 1. 50-60 ft. 2. ft. 3. ft.  
 WELL'S STATIC WATER LEVEL 5.5 ft. below land surface measured on mo/day/yr 2-17-95  
 Pump test data: Well water was ft. after hours pumping gpm  
 Est. Yield 3 gpm: Well water was ft. after hours pumping gpm  
 Bore Hole Diameter: 8 3/4 in. to 20 ft., and 6 3/4 in. to 68 ft.  
 WELL WATER TO BE USED AS: 5 Public water supply 8 Air conditioning 11 Injection well  
 1 Domestic 3 Feedlot 6 Oil field water supply 9 Dewatering 12 Other (Specify below)  
 2 Irrigation 4 Industrial 7 Lawn and garden only 10 Monitoring well

Was a chemical/bacteriological sample submitted to Department? Yes No; If yes, mo/day/yr sample was submitted  
 Water Well Disinfected? Yes X No

5 TYPE OF BLANK CASING USED: 1 Steel 3 RMP (SR) 5 Wrought iron 8 Concrete tile CASING JOINTS: Glued X Clamped  
 2 PVC 4 ABS 6 Asbestos-Cement 9 Other (specify below) Welded  
 7 Fiberglass Threaded

Blank casing diameter 5 in. to 58 ft., Dia. in. to ft., Dia. in. to ft.  
 Casing height above land surface 30 in., weight 200 lbs./ft. Wall thickness or gauge No.

TYPE OF SCREEN OR PERFORATION MATERIAL: 1 Steel 3 Stainless steel 5 Fiberglass 8 RMP (SR) 10 Asbestos-cement  
 2 Brass 4 Galvanized steel 6 Concrete tile 9 ABS 11 Other (specify)  
 7 PVC 12 None used (open hole)

SCREEN OR PERFORATION OPENINGS ARE: 1 Continuous slot 3 Mill slot 5 Gauzed wrapped 8 Saw cut 11 None (open hole)  
 2 Louvered shutter 4 Key punched 6 Wire wrapped 9 Drilled holes  
 7 Torch cut 10 Other (specify)

SCREEN-PERFORATED INTERVALS: From 58 ft. to 68 ft., From ft. to ft.  
 GRAVEL PACK INTERVALS: From ft. to ft., From ft. to ft.

6 GROUT MATERIAL: 1 Neat cement 2 Cement grout 3 Bentonite 4 Other  
 Grout intervals: From 20 ft. to 0 ft., From ft. to ft., From ft. to ft.

What is the nearest source of possible contamination: NONE  
 1 Septic tank 4 Lateral lines 7 Pit privy 10 Livestock pens 14 Abandoned water well  
 2 Sewer lines 5 Cess pool 8 Sewage lagoon 11 Fuel storage 15 Oil well/Gas well  
 3 Watertight sewer lines 6 Seepage pit 9 Feedyard 12 Fertilizer storage 16 Other (specify below)  
 13 Insecticide storage

Direction from well? How many feet?

FROM	TO	LITHOLOGIC LOG	FROM	TO	PLUGGING INTERVALS
0	33	SANDSTONE - Silty brown			
33	60	SANDSTONE - white			
60	68	Shale			

7 CONTRACTOR'S OR LANDOWNER'S CERTIFICATION: This water well was (1) constructed, (2) reconstructed, or (3) plugged under my jurisdiction and was completed on (mo/day/year) 2-17-95 and this record is true to the best of my knowledge and belief. Kansas Water Well Contractor's License No. 561 This Water Well Record was completed on (mo/day/yr) 2-26-95 under the business name of EVANS ENERGY DEVELOPMENT, INC. by (signature) Scott R. Evans