


1 LOCATION OF WATER WELL: County: Franklin Fraction: NW 1/4 SE 1/4 SE 1/4 Section Number: 12 Township Number: T 17 S Range Number: R 18 EW

Distance and direction from nearest town or city street address of well if located within city? 1604 LABETTE Rd. OTTAWA, Ks. 66067

2 WATER WELL OWNER: Jim Gilliland RR#, St. Address, Box #: 1671 Labette Drive City, State, ZIP Code: OTTAWA, Ks. 66067 Board of Agriculture, Division of Water Resources Application Number:

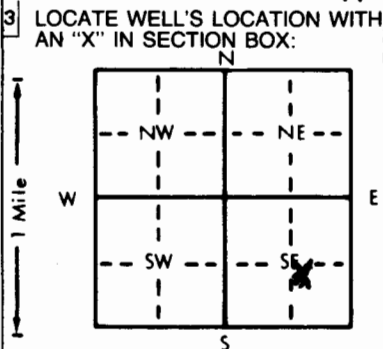

4 DEPTH OF COMPLETED WELL: 88 ft. ELEVATION: Depth(s) Groundwater Encountered: 1. 53-74 ft. 2. ft. 3. ft. WELL'S STATIC WATER LEVEL: 53 ft. below land surface measured on mo/day/yr 2-17-95 Pump test data: Well water was ft. after hours pumping gpm Est. Yield: 1 gpm Well water was ft. after hours pumping gpm Bore Hole Diameter: 8 3/4 in. to 20 ft., and 6 3/4 in. to 88 ft. WELL WATER TO BE USED AS: 1 Domestic 3 Feedlot 6 Oil field water supply 9 Dewatering 12 Other (Specify below) 2 Irrigation 4 Industrial 7 Lawn and garden only 10 Monitoring well Was a chemical/bacteriological sample submitted to Department? Yes No; If yes, mo/day/yr sample was submitted Water Well Disinfected? Yes X No

5 TYPE OF BLANK CASING USED: 1 Steel 3 RMP (SR) 5 Wrought iron 8 Concrete tile CASING JOINTS: Glued X Clamped Welded Threaded 2 PVC 4 ABS 6 Asbestos-Cement 9 Other (specify below) 7 Fiberglass Blank casing diameter: 5 in. to 78 ft., Dia. in. to in. to in. to Dia. in. to in. to Casing height above land surface: 30 in., weight: 200 lbs./ft. Wall thickness or gauge No.

TYPE OF SCREEN OR PERFORATION MATERIAL: 1 Steel 3 Stainless steel 5 Fiberglass 8 RMP (SR) 11 Other (specify) 2 Brass 4 Galvanized steel 6 Concrete tile 9 ABS 12 None used (open hole) 7 PVC 10 Asbestos-cement

SCREEN OR PERFORATION OPENINGS ARE: 1 Continuous slot 3 Mill slot 5 Gauzed wrapped 8 Saw cut 11 None (open hole) 2 Louvered shutter 4 Key punched 6 Wire wrapped 9 Drilled holes 7 Torch cut 10 Other (specify)

SCREEN-PERFORATED INTERVALS: From 78 ft. to 88 ft., From ft. to ft. to ft. to GRAVEL PACK INTERVALS: From ft. to ft. to ft. to ft. to ft. to ft. to ft. to

6 GROUT MATERIAL: 1 Neat cement 2 Cement grout 3 Bentonite 4 Other Grout Intervals: From 20 ft. to 0 ft., From ft. to ft. to ft. to ft. to ft. to ft. to What is the nearest source of possible contamination: NONE 1 Septic tank 4 Lateral lines 7 Pit privy 10 Livestock pens 14 Abandoned water well 2 Sewer lines 5 Cess pool 8 Sewage lagoon 11 Fuel storage 15 Oil well/Gas well 3 Watertight sewer lines 6 Seepage pit 9 Feedyard 12 Fertilizer storage 16 Other (specify below) 13 Insecticide storage

Direction from well? How many feet? LITHOLOGIC LOG PLUGGING INTERVALS

FROM	TO	LITHOLOGIC LOG	FROM	TO	PLUGGING INTERVALS
0	28	Sandstone - Silty brown			
28	74	Sandstone - white			
74	88	Shale			

7 CONTRACTOR'S OR LANDOWNER'S CERTIFICATION: This water well was (1) constructed (2) reconstructed, or (3) plugged under my jurisdiction and was completed on (mo/day/year) 2-17-95 and this record is true to the best of my knowledge and belief. Kansas Water Well Contractor's License No. 561 This Water Well Record was completed on (mo/day/yr) 2-26-95 under the business name of EVANS ENERGY Dev. Inc. by (signature) [Signature]