


1 LOCATION OF WATER WELL: County: Franklin Fraction: NE 1/4 SE 1/4 SE 1/4 Section Number: 12 Township Number: T 17 S Range Number: R 18 EW

Distance and direction from nearest town or city street address of well if located within city?  
1608 Labette Rd OTTAWA, KS 66028

2 WATER WELL OWNER: Jim Billiland  
 RR#, St. Address, Box #: 1671 Labette DR. Board of Agriculture, Division of Water Resources  
 City, State, ZIP Code: OTTAWA, KS 66067 Application Number:

3 LOCATE WELL'S LOCATION WITH AN "X" IN SECTION BOX: 4 DEPTH OF COMPLETED WELL: 100 ft. ELEVATION: \_\_\_\_\_

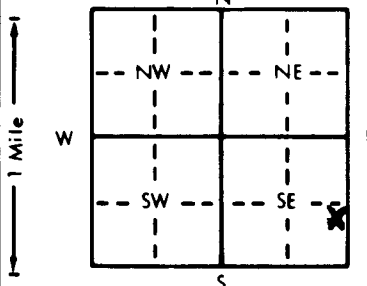

Depth(s) Groundwater Encountered 1. 56-80 ft. 2. \_\_\_\_\_ ft. 3. \_\_\_\_\_ ft.  
 WELL'S STATIC WATER LEVEL 56 ft. below land surface measured on mo/day/yr 2-17-95  
 Pump test data: Well water was \_\_\_\_\_ ft. after \_\_\_\_\_ hours pumping \_\_\_\_\_ gpm  
 Est. Yield 1 gpm: Well water was \_\_\_\_\_ ft. after \_\_\_\_\_ hours pumping \_\_\_\_\_ gpm  
 Bore Hole Diameter: 8 3/4 in. to 20 ft., and 6 3/4 in. to 100 ft.  
 WELL WATER TO BE USED AS:  
 1 Domestic     3 Feedlot     6 Oil field water supply     9 Dewatering     11 Injection well  
 2 Irrigation     4 Industrial     7 Lawn and garden only     10 Monitoring well  
 Was a chemical/bacteriological sample submitted to Department? Yes \_\_\_\_\_ No \_\_\_\_\_; If yes, mo/day/yr sample was submitted \_\_\_\_\_  
 Water Well Disinfected? Yes  No \_\_\_\_\_

5 TYPE OF BLANK CASING USED:  
 1 Steel     3 RMP (SR)     5 Wrought iron     8 Concrete tile    CASING JOINTS: Glued  Clamped \_\_\_\_\_  
 2 PVC     4 ABS     6 Asbestos-Cement     9 Other (specify below)    Welded \_\_\_\_\_  
 Blank casing diameter \_\_\_\_\_ in. to \_\_\_\_\_ ft., Dia. \_\_\_\_\_ in. to \_\_\_\_\_ ft., Dia. \_\_\_\_\_ in. to \_\_\_\_\_ ft.  
 Casing height above land surface: 30 in., weight 200 lbs./ft. Wall thickness or gauge No. \_\_\_\_\_  
 TYPE OF SCREEN OR PERFORATION MATERIAL:  
 1 Steel     3 Stainless steel     5 Fiberglass     7 PVC     10 Asbestos-cement  
 2 Brass     4 Galvanized steel     6 Concrete tile     9 ABS     11 Other (specify) \_\_\_\_\_  
 12 None used (open hole)  
 SCREEN OR PERFORATION OPENINGS ARE:  
 1 Continuous slot     3 Mill slot     5 Gauzed wrapped     8 Saw cut     11 None (open hole)  
 2 Louvered shutter     4 Key punched     6 Wire wrapped     9 Drilled holes  
 7 Torch cut     10 Other (specify) \_\_\_\_\_

SCREEN-PERFORATED INTERVALS: From 90 ft. to 100 ft., From \_\_\_\_\_ ft. to \_\_\_\_\_ ft.  
 From \_\_\_\_\_ ft. to \_\_\_\_\_ ft., From \_\_\_\_\_ ft. to \_\_\_\_\_ ft.  
 GRAVEL PACK INTERVALS: From \_\_\_\_\_ ft. to \_\_\_\_\_ ft., From \_\_\_\_\_ ft. to \_\_\_\_\_ ft.  
 From \_\_\_\_\_ ft. to \_\_\_\_\_ ft., From \_\_\_\_\_ ft. to \_\_\_\_\_ ft.

6 GROUT MATERIAL:  1 Neat cement     2 Cement grout     3 Bentonite     4 Other \_\_\_\_\_  
 Grout Intervals: From 20 ft. to 0 ft., From \_\_\_\_\_ ft. to \_\_\_\_\_ ft., From \_\_\_\_\_ ft. to \_\_\_\_\_ ft.  
 What is the nearest source of possible contamination:  
 1 Septic tank     4 Lateral lines     7 Pit privy     10 Livestock pens     14 Abandoned water well  
 2 Sewer lines     5 Cess pool     8 Sewage lagoon     11 Fuel storage     15 Oil well/Gas well  
 3 Watertight sewer lines     6 Seepage pit     9 Feedyard     12 Fertilizer storage     16 Other (specify below)  
 13 Insecticide storage  
 Direction from well? SW How many feet? 50

FROM	TO	LITHOLOGIC LOG	FROM	TO	PLUGGING INTERVALS
0	18	Sandstone			
18	40	Shale			
40	43	Sandstone - Brown			
43	46	Sandstone - Lt. Grey			
46	49	Silty Shale			
49	53	Lime			
53	56	Shale			
56	80	Sandstone - White			
80	89	Silty Shale			
89	100	Shale			

7 CONTRACTOR'S OR LANDOWNER'S CERTIFICATION: This water well was  (1) constructed,  (2) reconstructed, or  (3) plugged under my jurisdiction and was completed on (mo/day/year) 2-17-95 and this record is true to the best of my knowledge and belief. Kansas Water Well Contractor's License No. 561 This Water Well Record was completed on (mo/day/yr) 2-26-95 under the business name of EVANS Energy Development, Inc. by (signature) SETH E.