

1 LOCATION OF WATER WELL: County: <u>FRANKLIN</u>	Fraction <u>NE</u> <u>NW</u> $\frac{1}{4}$ <u>NW</u> $\frac{1}{4}$ <u>NW</u> $\frac{1}{4}$	Section Number <u>30</u>	Township Number T <u>17</u> S	Range Number R <u>19</u> E/W
--	---	-----------------------------	----------------------------------	---------------------------------

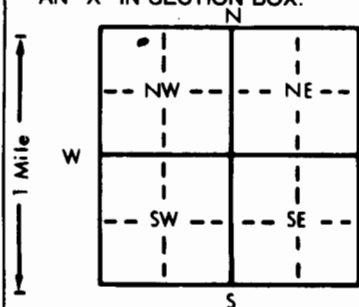
Distance and direction from nearest town or city street address of well if located within city?

5 miles west of Ottawa. 2 1/2 miles north 1 east of Homewood.2 WATER WELL OWNER: Harry H CathronRR#, St. Address, Box #: RR 3City, State, ZIP Code: Ottawa Kansas 66067

Board of Agriculture, Division of Water Resources

Application Number:

3 LOCATE WELL'S LOCATION WITH AN "X" IN SECTION BOX:

4 DEPTH OF COMPLETED WELL: 100 ft. ELEVATION:Depth(s) Groundwater Encountered 1. 35 ft. 2. \_\_\_\_\_ ft. 3. \_\_\_\_\_ ft.WELL'S STATIC WATER LEVEL 25 ft. below land surface measured on mo/day/yr 5 25 1986

Pump test data: Well water was \_\_\_\_\_ ft. after \_\_\_\_\_ hours pumping \_\_\_\_\_ gpm

Est. Yield 5 gpm: Well water was \_\_\_\_\_ ft. after \_\_\_\_\_ hours pumping \_\_\_\_\_ gpmBore Hole Diameter 8 in. to 100 ft., and \_\_\_\_\_ in. to \_\_\_\_\_ ft.

WELL WATER TO BE USED AS: 5 Public water supply 8 Air conditioning 11 Injection well

1 Domestic 3 Feedlot 6 Oil field water supply 9 Dewatering 12 Other (Specify below)

2 Irrigation 4 Industrial 7 Lawn and garden only 10 Observation well

Was a chemical/bacteriological sample submitted to Department? Yes \_\_\_\_\_ No X If yes, mo/day/yr sample was submittedWater Well Disinfected? Yes X No

5 TYPE OF BLANK CASING USED:

5 Wrought iron

8 Concrete tile

CASING JOINTS: Glued X Clamped \_\_\_\_\_

1 Steel

3 RMP (SR)

6 Asbestos-Cement

9 Other (specify below)

Welded \_\_\_\_\_

2 PVC

4 ABS

7 Fiberglass

Threaded \_\_\_\_\_

Blank casing diameter 5 in. to 80 ft. Dia 2 ft. Dia \_\_\_\_\_ in. to \_\_\_\_\_ ft.Casing height above land surface 18 in., weight sec 80 lbs./ft. Wall thickness or gauge No. \_\_\_\_\_

TYPE OF SCREEN OR PERFORATION MATERIAL:

1 Steel

3 Stainless steel

5 Fiberglass

7 PVC

10 Asbestos-cement

2 Brass

4 Galvanized steel

6 Concrete tile

8 RMP (SR)

11 Other (specify) \_\_\_\_\_

9 ABS

12 None used (open hole)

SCREEN OR PERFORATION OPENINGS ARE:

1 Continuous slot

3 Mill slot

5 Gauzed wrapped

8 Saw cut

11 None (open hole)

2 Louvered shutter

4 Key punched

6 Wire wrapped

9 Drilled holes

2 Louvered shutter

4 Key punched

7 Torch cut

10 Other (specify) \_\_\_\_\_

SCREEN-PERFORATED INTERVALS: From 80 ft. to 100 ft. From \_\_\_\_\_ ft. to \_\_\_\_\_ ft.

From \_\_\_\_\_ ft. to \_\_\_\_\_ ft. From \_\_\_\_\_ ft. to \_\_\_\_\_ ft.

GRAVEL PACK INTERVALS: From 20 ft. to 100 ft. From \_\_\_\_\_ ft. to \_\_\_\_\_ ft.

From \_\_\_\_\_ ft. to \_\_\_\_\_ ft. From \_\_\_\_\_ ft. to \_\_\_\_\_ ft.

6 GROUT MATERIAL:

1 Neat cement

2 Cement grout

3 Bentonite

4 Other \_\_\_\_\_

Grout intervals: From 15 ft. to 20 ft. From 3 ft. to 8 ft. From \_\_\_\_\_ ft. to \_\_\_\_\_ ft.

What is the nearest source of possible contamination:

1 Septic tank

4 Lateral lines

7 Pit privy

10 Livestock pens

14 Abandoned water well

2 Sewer lines

5 Cess pool

8 Sewage lagoon

11 Fuel storage

15 Oil well/Gas well

3 Watertight sewer lines

6 Seepage pit

9 Feedyard

12 Fertilizer storage

16 Other (specify below)

13 Insecticide storage

Direction from well? North EastHow many feet? 100

FROM	TO	LITHOLOGIC LOG	FROM	TO	LITHOLOGIC LOG
0	4	Top soil.			
4	47	sand rock			
47	100	Shale			
		TID 100ft.			

RECEIVED

SEP 15 1986

DIVISION OF ENVIRONMENT

7 CONTRACTOR'S OR LANDOWNER'S CERTIFICATION: This water well was (1) constructed, (2) reconstructed, or (3) plugged under my jurisdiction and was completed on (mo/day/year) 5 25 1986 and this record is true to the best of my knowledge and belief. KansasWater Well Contractor's License No. 212 This Water Well Record was completed on (mo/day/yr) 9 12 86under the business name of Kenneth Schmit by (signature) Kenneth Schmit

INSTRUCTIONS: Use typewriter or ball point pen. PLEASE PRESS FIRMLY and PRINT clearly. Please fill in blanks, underline or circle the correct answers. Send top three copies to Kansas Department of Health and Environment, Office of Oil Field and Environmental Geology, Regulation and Permitting Section, Topeka, Kansas 66620-7500, Telephone: 913/862-9360. Send one to WATER WELL OWNER and retain one for your records.