


1	LOCATION OF WATER WELL: County: <u>Franklin</u>	Fraction <u>N 1/2 NE 1/4 NE 1/4</u>	Section <u>14</u>	Number	Township <u>17 S</u>	Number	Range <u>19 E</u>	Number
---	--	--	----------------------	--------	-------------------------	--------	----------------------	--------

Distance and direction from nearest town or city street address of well if located within city?
Atte East 23rd St Ottawa, KS 210 W. 23rd St

2	WATER WELL OWNER: RR #, St. Address, Box #: City, State, ZIP Code :	<u>Ed Wolken</u> <u>Wolken Oil Company</u> <u>P.O. Box 352</u> <u>Garnett, Kansas 66032</u>	Application Number: <u>MW-7, Per drilled, 6/1/2017</u>
---	---	--	---

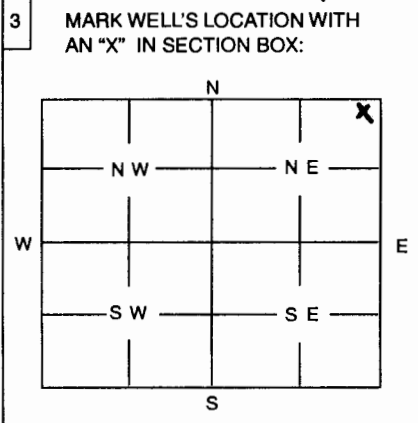

4 DEPTH OF WELL 10 ft

WELL'S STATIC WATER LEVEL 4 ft.

WELL WAS USED AS:

1 Domestic	5 Public Water Supply	9 Dewatering
2 Irrigation	6 Oil Field Water Supply	<u>10 Monitoring Well</u>
3 Feedlot	7 Domestic (Lawn & Garden)	11 Injection Well
4 Industrial	8 Air Conditioning	12 Other

Was a chemical / bacteriological sample submitted to Department? Yes No X

If yes, mo/day/yr sample was submitted

Water Well Disinfected: Yes No X

5 TYPE OF BLANK CASING USED:

1 Steel	3 RMP (SR)	5 Wrought	7 Fiberglass	9 Other (Specify below)
<u>2 PVC</u>	4 ABS	6 Asbestos-Cement	8 Concrete Tile	

Blank casing diameter in. Was casing pulled? Yes X No If yes, how much 10'

Casing height above or below land surface in.

6 GROUT PLUG MATERIAL: 1 Neat cement 2 Cement grout 3 Bentonite 4 Other

Grout Plug Intervals: From ft. to ft., From ft. to ft., From to ft.

What is the nearest source of possible contamination:

1 Septic tank	6 Seepage pit	<u>11 Fuel storage</u>	16 Other (specify below)
2 Sewer lines	7 Pit privy	12 Fertilizer storage	
3 Watertight sewer lines	8 Sewage lagoon	13 Insecticide storage	
4 Lateral lines	9 Feedyard	14 Abandoned water well	
5 Cess Pool	10 Livestock pens	15 Oil well/Gas well	

Direction from well? NW How many feet? 20'

FROM	TO	PLUGGING MATERIALS
<u>10</u>	<u>2</u>	<u>Cement / Bentonite</u>
<u>2</u>	<u>0</u>	<u>Soil / Gravel</u>

7 CONTRACTOR'S OR LANDOWNER'S CERTIFICATION: This water well was plugged under my jurisdiction and was completed on (mo/day/year) 2/24/01 and this record is true to the best of my knowledge and belief. Kansas Water Well Contractor's License No. 014 This Water Well Record was completed on (mo/day/year) under the business name of Maxim Technologies by (signature) William Stegford

INSTRUCTIONS: Use typewriter or ball point pen. Please press firmly and print clearly. Please fill in blanks, underline or circle the correct answers. Send top three copies to Kansas Department of Health and Environment, Bureau of Water, Topeka, Kansas 66620-0001. Telephone: 785/296-3565. Send one to Water Well Owner and retain one for your records.