

WATER WELL PLUGGING RECORD Form WWC-5P

KSA 82a-1212

ID NO.


1 LOCATION OF WATER WELL: County: FRANKLIN	Fraction NW 1/4 SE 1/4 NE 1/4 NW 1/4	Section Number 13	Township Number T 17(S)	Range Number 19 ☒ E ☐ W
---	--	-----------------------------	-----------------------------------	--

Street/Rural Address of Well Location; if unknown, distance & direction from nearest town or intersection: If at owner's address, check here ☐ **408 E. 23RD ST (AKA 808 E.23)**
OTTAWA, KS 66067

Global Positioning Systems (GPS) Information:
Latitude: **34.733'** (in decimal degrees)
Longitude: **15.769'** (in decimal degrees)
Elevation: **912 FT**
Datum: ☐ WGS84, ☐ NAD83, ☐ NAD27
Collection Method:
☒ GPS unit (Make/Model: **LOWRANCE XOG**)
☐ Digital Map/Photo, ☐ Topographic Map, ☐ Land Survey
Est. Accuracy: ☐ < 3 m, ☒ 3-5 m, ☐ 5-15 m, ☐ > 15 m

2 WATER WELL OWNER: LES MEHARRY
RR#, St. Address, Box #: **10108 W. 70TH ST**
City, State ZIP Code: **MERRIAM, KS 66203**

3 MARK WELL'S LOCATION WITH AN "X" IN SECTION BOX:

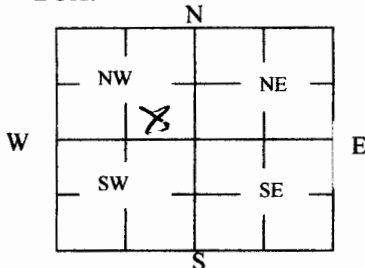

4 DEPTH OF WELL 14 ft.

WELL'S STATIC WATER LEVEL 6 ft

WELL WAS USED AS:

☒ Domestic	☐ Public Water Supply	☐ Dewatering
☐ Irrigation	☐ Oil Field Water Supply	☐ Monitoring
☐ Feedlot	☐ Domestic (Lawn & Garden)	☐ Injection Well
☐ Industrial	☐ Air Conditioning	☐ Other _____

Was a chemical/bacteriological sample submitted to Department? Yes ☐ No ☒

5 TYPE OF BLANK CASING USED:

☐ Steel ☐ RMP (SR) ☐ Wrought ☐ Fiberglass ☒ Other (Specify below) **BLOCK/BRICK**
☐ PVC ☐ ABS ☐ Asbestos-Cement ☐ Concrete Tile

Blank casing diameter 34 in. Was casing pulled? Yes ☒ No ☐ If yes, how much TOP 5 FEET
Casing height above or below land surface 5' BELOW in.

6 GROUT PLUG MATERIAL: ☐ Neat cement ☒ Cement grout ☐ Bentonite ☐ Other _____

Grout Plug Intervals: From _____ ft. to _____ ft., From _____ ft. to _____ ft., From _____ to _____ ft.

What is the nearest source of possible contamination:

☒ Septic tank	☐ Seepage pit	☐ Fuel Storage	☐ Other (specify below) _____
☐ Sewer lines	☐ Pit privy	☐ Fertilizer storage	
☐ Watertight sewer lines	☐ Sewage lagoon	☐ Insecticide storage	
☐ Lateral lines	☐ Feedyard	☐ Abandoned water well	
☐ Cess pool	☐ Livestock pens	☐ Oil well/Gas well	

Direction from well? SE
How many feet? 40

FROM	TO	PLUGGING MATERIALS	FROM	TO	PLUGGING MATERIALS
14	5	SAND/GRAVEL			2 GAL BLEACH POURED IN WELL
5	4.5	CEMENT GROUT			PRIOR TO PLUGGING.
4.5	0	COMPACTED CLAY DIRT			

**Original Returned to Sender
for Correction Date: 5-4-10**

7 CONTRACTOR'S OR LANDOWNER'S CERTIFICATION: This water well was plugged under my jurisdiction and was completed on (mo/day/year) 4/28/2010 and this record is true to the best of my knowledge and belief. Kansas Water Well Contractor's License No. _____. This Water Well Record was completed on (mo/day/year) 4/30/2010 under the business name of HARVEY BROTHERS WRECKING by (signature) [Signature]

INSTRUCTIONS: Use typewriter or ballpoint pen. Please press firmly and print clearly. Please fill in blanks, underline or circle the correct answers. Send top three copies to Kansas Department of Health and Environment, Bureau of Water, Geology Section, 1000 SW Jackson St., Ste. 420, Topeka, Kansas 66612-1367. Telephone: 785/296-5524. Send one to Water Well Owner and retain one for your records. Visit us at <http://www.kdheks.gov/waterwell/index.html>.

Check one: ☒ White Copy ☐ Blue Copy ☐ Pink Copy