

WATER WELL PLUGGING RECORD Form WWC-5P

KSA 82a-1212

ID NO.

1 LOCATION OF WATER WELL: County: Franklin Fraction: NW 1/4 SE 1/4 NE 1/4 NW 1/4 Section Number: 13 Township Number: T 17 S Range Number: 19 ☒ E ☐ W

Street/Rural Address of Well Location; if unknown, distance & direction from nearest town or intersection: If at owner's address, check here ☐ 408 E. 23rd St. (AKA 808 E. 23 ST)

Ottawa, Ks. 66067

Global Positioning Systems (GPS) information:

Latitude: 34.725' (in decimal degrees)

Longitude: 15.777' (in decimal degrees)

Elevation: 905 FT

Datum: ☐ WGS84, ☐ NAD83, ☐ NAD27

Collection Method:


☒ GPS unit (Make/Model: LOWRANCE XOG)

☐ Digital Map/Photo, ☐ Topographic Map, ☐ Land Survey

Est. Accuracy: ☐ < 3 m, ☒ 3-5 m, ☐ 5-15 m, ☐ > 15 m

2 WATER WELL OWNER: LES MEHARRY
RR#, St. Address, Box #: 10108 W. 70TH ST.
City, State ZIP Code: MERRIAM, KS 66203

3 MARK WELL'S LOCATION WITH AN "X" IN SECTION BOX:

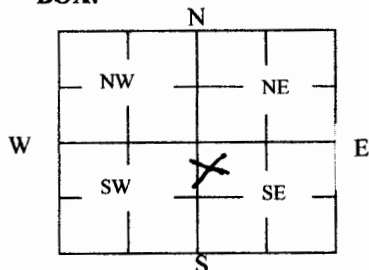

4 DEPTH OF WELL 20 ft.

WELL'S STATIC WATER LEVEL 6 ft

WELL WAS USED AS:

☒ Domestic
☐ Irrigation
☐ Feedlot
☐ Industrial

☐ Public Water Supply
☐ Oil Field Water Supply
☐ Domestic (Lawn & Garden)
☐ Air Conditioning

☐ Dewatering
☐ Monitoring
☐ Injection Well
☐ Other

Was a chemical/bacteriological sample submitted to Department? Yes ☐ No ☒

5 TYPE OF BLANK CASING USED:

☐ Steel
☐ PVC

☐ RMP (SR)
☐ ABS

☐ Wrought
☐ Asbestos-Cement

☐ Fiberglass
☐ Concrete Tile

☒ Other (Specify below)
BLOCK/BRICK

Blank casing diameter 70 in. Was casing pulled? Yes ☒ No ☐ If yes, how much TOP 5 FEET

Casing height above or below land surface 5' BELOW in.

6 GROUT PLUG MATERIAL:

☐ Neat cement

☒ Cement grout

☐ Bentonite

☐ Other

Grout Plug Intervals: From ft. to ft., From ft. to ft., From to ft.

What is the nearest source of possible contamination:

☒ Septic tank
☐ Sewer lines
☐ Watertight sewer lines
☐ Lateral lines
☐ Cess pool

☐ Seepage pit
☐ Pit privy
☐ Sewage lagoon
☐ Feedyard
☐ Livestock pens

☐ Fuel Storage
☐ Fertilizer storage
☐ Insecticide storage
☐ Abandoned water well
☐ Oil well/Gas well

☐ Other (specify below)

Direction from well? W
How many feet? 30

FROM	TO	PLUGGING MATERIALS	FROM	TO	PLUGGING MATERIALS
20	5	SAND/GRAVEL			2 GAL BLEACH POURED IN WELL
5	4.5	CEMENT GROUT			PRIOR TO PLUGGING
4.5	0	COMPACTED CLAY DIRT			

Original Returned to Sender
for Correction Date: 5-4-10

7 CONTRACTOR'S OR LANDOWNER'S CERTIFICATION: This water well was plugged under my jurisdiction and was completed on (mo/day/year) 4/28/2010 and this record is true to the best of my knowledge and belief. Kansas Water Well Contractor's License No. . This Water Well Record was completed on (mo/day/year) 4/30/2010 under the business name of HARVEY BROTHERS WRECKING by (signature) Harvey Brothers Wrecking

INSTRUCTIONS: Use typewriter or ballpoint pen. Please press firmly and print clearly. Please fill in blanks, underline or circle the correct answers. Send top three copies to Kansas Department of Health and Environment, Bureau of Water, Geology Section, 1000 SW Jackson St., Ste. 420, Topeka, Kansas 66612-1367. Telephone: 785/296-5524. Send one to Water Well Owner and retain one for your records. Visit us at <http://www.kdheks.gov/waterwell/index.html>.

Check one: ☒ White Copy ☐ Blue Copy ☐ Pink Copy