

WATER WELL RECORD

Form WWC-5


Division of Water Resources App. No.

1 LOCATION OF WATER WELL: County: Franklin	Fraction SW ¼ SE ¼ NE ¼ NE ¼	Section Number 11	Township No. T 17 S	Range Number R 19 <input checked="" type="checkbox"/> E <input type="checkbox"/> W
--	---------------------------------	----------------------	------------------------	---

Street/Rural Address of Well Location; if unknown, distance & direction from nearest town or intersection: If at owner's address, check here .
 South Main Street and 17th
 Ottawa, KS 66067

Global Positioning System (GPS) information:
 Latitude: 38.59039 (in decimal degrees)
 Longitude: 95.26917 (in decimal degrees)
 Elevation: 932.07 (ft)
 Datum: WGS 84, NAD 83, NAD 27
 Collection Method:
 GPS unit (Make/Model:)
 Digital Map/Photo, Topographic Map, Land Survey
 Est. Accuracy: <3 m, 3-5 m, 5-15 m, >15 m

2 WATER WELL OWNER: KDHE - BER
 RR#, Street Address, Box #: 1000 SW Jackson St. Ste. 410
 City, State, ZIP Code : Topeka, KS 66612-1367

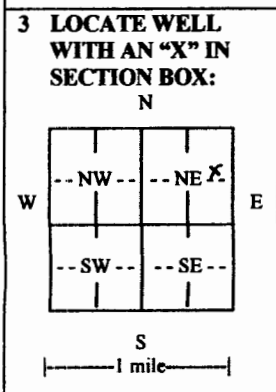

4 DEPTH OF COMPLETED WELL 27 ft

Depth(s) Groundwater Encountered (1) Dry ft. (2) N/A ft. (3) N/A ft.

WELL'S STATIC WATER LEVEL Dry ft. below land surface measured on mo/day/yr. 3/24/15

Pump test data: Well water was N/A ft. after N/A hours pumping. N/A gpm

EST. YIELD. N/A gpm. Well water was N/A ft. after N/A hours pumping. N/A gpm

Bore Hole Diameter 8.25 in. to 27 ft. and N/A in. to N/A ft.

WELL WATER TO BE USED AS: Public water supply Geothermal Injection well
 Domestic Feedlot Oil field water supply Dewatering Other (Specify below)
 Irrigation Industrial Domestic-lawn & garden Monitoring well MW-5

Was a chemical/bacteriological sample submitted to Department? Yes No

If yes, mo/day/yr sample was submitted N/A

Water well disinfected? Yes No

5 TYPE OF CASING USED: Steel PVC Other

CASING JOINTS: Glued Clamped Welded Threaded

Casing diameter 2 in. to 12 ft. Diameter N/A in. to N/A ft. Diameter N/A in. to N/A ft.

Casing height above land surface 0 in. Weight N/A lbs./ft. Wall thickness or gauge No. Schedule 40

TYPE OF SCREEN OR PERFORATION MATERIAL:
 Steel Stainless Steel PVC Other (Specify)
 Brass Galvanized Steel None used (open hole)

SCREEN OR PERFORATION OPENINGS ARE:
 Continuous slot Mill slot Gauze wrapped Torch cut Drilled holes None (open hole)
 Louvered shutter Key punched Wire wrapped Saw cut Other (specify)

SCREEN-PERFORATED INTERVALS: From 12 ft. to 27 ft. From N/A ft. to N/A ft. From N/A ft. to N/A ft.

GRAVEL PACK INTERVALS: From 10 ft. to 27 ft. From N/A ft. to N/A ft. From N/A ft. to N/A ft.

6 GROUT MATERIAL: Neat cement Cement grout Bentonite Other Concrete 0 to 2-feet

Grout Intervals: From 2 ft. to 10 ft. From N/A ft. to N/A ft. From N/A ft. to N/A ft.

What is the nearest source of possible contamination:
 Septic tank Lateral lines Pit privy Livestock pens Insecticide storage Other (specify below)
 Sewer lines Cesspool Sewage lagoon Fuel storage Abandoned water well
 Watertight sewer lines Seepage pit Feedyard Fertilizer storage Oil well/gas well

Direction from well SW Distance from well 28'

FROM	TO	LITHOLOGIC LOG	FROM	TO	LITHO. LOG (cont.) or PLUGGING INTERVALS
0	0.5	Gravel	25.5	27	Sandy CLAY Lt tan moist stiff w/ chert gravel
0.5	1.5	broken concrete			
1.5	6.5	Silty CLAY DK gray stained very moist soft			
6.5	12.5	FAT CLAY Lt gray to yellow brown moist stiff some iron oxide nodules			
12.5	16	FAT CLAY Lt gray to yellow brown moist stiff some Fe oxide nodules			
16	25.5	Sandy clayey SILT Lt gray red stiff moist			

7 CONTRACTOR'S OR LANDOWNER'S CERTIFICATION: This water well was constructed, reconstructed, or plugged under my jurisdiction and was completed on (mo/day/year) 3/20/15 and this record is true to the best of my knowledge and belief. Kansas Water Well Contractor's License No. 759. This Water Well Record was completed on (mo/day/year) 4/5/2015 under the business name of RAZEK Environmental, LLC by (signature) [Signature]

INSTRUCTIONS: Use typewriter or ball point pen. PLEASE PRESS FIRMLY and PRINT clearly. Please fill in blanks and check the correct answers. Send one copy to Kansas Department of Health and Environment, Bureau of Water, Geology Section, 1000 SW Jackson St., Suite 420, Topeka, Kansas 66612-1367. Telephone 785-296-5524. Send one copy to WATER WELL OWNER and retain one for your records. Include fee of \$5.00 for each constructed well. Visit us at <http://www.kdheks.gov/waterwell/index.html>