

County: Franklin Fraction: NE SE NE NE Sec. 13 T. 17 S R. 19 E

CORRECTION(S) to WATER WELL COMPLETION RECORD Form WWC-5 (to rectify lacking or incorrect information)

Owner: City of Ottawa

If location corrected, was listed as:

Section-Township-Range: 25-17-19

Fraction (¼ calls): _____

Location changed to:

13-17-19E

NE SE NE NE

Other changes: Initial statements: _____

Latitude 38 degrees 34.604 min Longitude -95 degrees 15.020 min

Changed to: Latitude 38.576733 Longitude -95.250333 WGS84

Comments: _____

Verification method: Used Leoweb to get quarter fractions from the Lat/Long verified with KGS mapper

Initials: SH Date: 11-30-208

Submitted by: Kansas Geological Survey, Data Resources Library, 1930 Constant Ave., Lawrence, KS 66047-3724
 Kansas Dept. of Health & Environment, Bureau of Water, 1000 SW Jackson, Suite 420, Topeka, KS 66612-1367


WATER WELL PLUGGING RECORD Form WWC-5P

KSA 82a-1212 ⁷ ID NO.

1 **LOCATION OF WATER WELL:** Fraction $\frac{1}{4}$ $\frac{1}{4}$ $\frac{1}{4}$ $\frac{1}{4}$ Section Number 25-13 Township Number T 17 S 13 Range Number 19 E W
 County: Franklin Co.

Street/Rural Address of Well Location; if unknown, distance & direction from nearest town or intersection: If at owner's address, check here
2660 Montana Rd.
 2 **WATER WELL OWNER:** City of Ottawa
 RR#, St. Address, Box #: PO Box 358
 City, State ZIP Code: Ottawa Ks 66066

Global Positioning Systems (GPS) information:
 Latitude: N 38° 34.604' (in decimal degrees)
 Longitude: W. 095° 15.020' (in decimal degrees)
 Elevation: 869'
 Datum: WGS84, NAD83, NAD27
 Collection Method:
 GPS unit (Make/Model: Garmin Zumo 660)
 Digital Map/Photo, Topographic Map, Land Survey
 Est. Accuracy: < 3 m, 3-5 m, 5-15 m, > 15 m

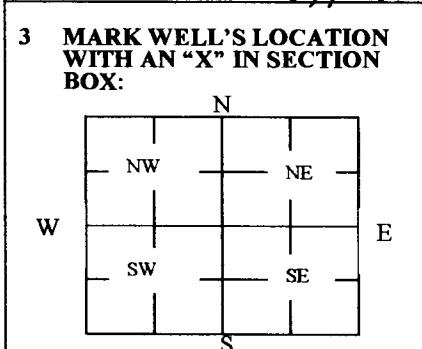

4 **DEPTH OF WELL** 30 ft.
 WELL'S STATIC WATER LEVEL 8 ft
 WELL WAS USED AS:
 Domestic Public Water Supply Dewatering
 Irrigation Oil Field Water Supply Monitoring
 Feedlot Domestic (Lawn & Garden) Injection Well
 Industrial Air Conditioning Other _____
 Was a chemical/bacteriological sample submitted to Department? Yes No

5 **TYPE OF BLANK CASING USED:**
 Steel RMP (SR) Wrought Fiberglass Other (Specify below) Rock
 PVC ABS Asbestos-Cement Concrete Tile
 Blank casing diameter 48 in. Was casing pulled? Yes No If yes, how much Top 5'
 Casing height above or below land surface 6' in.

6 **GROUT PLUG MATERIAL:** Neat cement Cement grout Bentonite Other _____
 Grout Plug Intervals: From _____ ft. to _____ ft., From _____ ft. to _____ ft., From _____ ft. to _____ ft.
 What is the nearest source of possible contamination:
 Septic tank Seepage pit Fuel storage Other (specify below) 1/4 mile
 Sewer lines Pit privy Fertilizer storage
 Watertight sewer lines Sewage lagoon Insecticide storage
 Lateral lines Feedyard Abandoned water well Oil well/Gas well
 Cess pool Livestock pens Direction from well? NE
 How many feet? _____

FROM	TO	PLUGGING MATERIALS	FROM	TO	PLUGGING MATERIALS
		<u>6 Sac Concrete</u>	<u>5'</u>	<u>4'</u>	

7 **CONTRACTOR'S OR LANDOWNER'S CERTIFICATION:** This water well was plugged under my jurisdiction and was completed on (mo/day/year) 1/1/2017 (KAS) and this record is true to the best of my knowledge and belief. Kansas Water Well Contractor's License No. _____ This Water Well Record was completed on (mo/day/year) _____ under the business name of Owner City of Ottawa by (signature) E. Degan

INSTRUCTIONS: Use typewriter or ballpoint pen. Please press firmly and print clearly. Please fill in blanks, underline or circle the correct answers. Send top three copies to Kansas Department of Health and Environment, Bureau of Water, Geology Section, 1000 SW Jackson St., Ste. 420, Topeka, Kansas 66612-1367. Telephone: 785/296-5524. Send one to Water Well Owner and retain one for your records. Visit us at <http://www.kdheks.gov/waterwell/index.html>.