


1 LOCATION OF WATER WELL: County: Franklin Fraction: NE 1/4 SE 1/4 NE 1/4 Section Number: 10 Township Number: T 17 S Range Number: R 20 EW

Distance and direction from nearest town or city street address of well if located within city?  
4 miles west of Ottawa and 1/3 mile South

2 WATER WELL OWNER: Robert Boyke  
 RR#, St. Address, Box #: 2444 Old 50 Highway Board of Agriculture, Division of Water Resources  
 City, State, ZIP Code: Ottawa, KS 66067 Application Number:

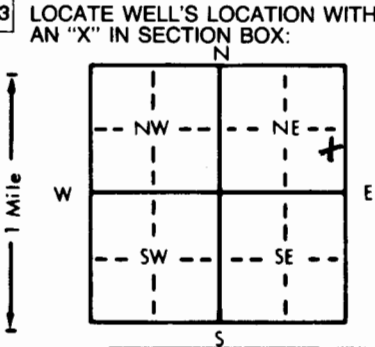

4 DEPTH OF COMPLETED WELL: 100' ft. ELEVATION:  
 Depth(s) Groundwater Encountered 1. 15-29 ft. 2. ft. 3. ft.  
 WELL'S STATIC WATER LEVEL 28 ft. below land surface measured on mo/day/yr 12-12-94  
 Pump test data: Well water was ft. after hours pumping gpm  
 Est. Yield 2 gpm; Well water was ft. after hours pumping gpm  
 Bore Hole Diameter: 8 3/4 in. to 20 ft., and 6 3/4 in. to 100 ft.  
 WELL WATER TO BE USED AS:  
 1 Domestic  3 Feedlot  6 Oil field water supply  9 Dewatering  12 Other (Specify below)  
 2 Irrigation  4 Industrial  7 Lawn and garden only  10 Monitoring well  
 Was a chemical/bacteriological sample submitted to Department? Yes No  If yes, mo/day/yr sample was submitted  
 Water Well Disinfected? Yes  No

5 TYPE OF BLANK CASING USED:  
 1 Steel  3 RMP (SR)  5 Wrought iron  8 Concrete tile CASING JOINTS: Glued  Clamped  
 2 PVC  4 ABS  6 Asbestos-Cement  9 Other (specify below) Welded  
 Blank casing diameter 5 in. to 9.0 ft., Dia. in. to ft., Dia. in. to ft.  
 Casing height above land surface 24 in., weight lbs./ft. Wall thickness or gauge No. 200#  
 TYPE OF SCREEN OR PERFORATION MATERIAL:  
 1 Steel  3 Stainless steel  5 Fiberglass  7 PVC  10 Asbestos-cement  
 2 Brass  4 Galvanized steel  6 Concrete tile  9 ABS  11 Other (specify)  
 SCREEN OR PERFORATION OPENINGS ARE:  
 1 Continuous slot  3 Mill slot  5 Gauzed wrapped  8 Saw cut  11 None (open hole)  
 2 Louvered shutter  4 Key punched  6 Wire wrapped  9 Drilled holes  
 7 Torch cut  10 Other (specify)

SCREEN-PERFORATED INTERVALS: From 90 ft. to 100 ft., From ft. to ft.  
 From ft. to ft., From ft. to ft.  
 GRAVEL PACK INTERVALS: From 100 ft. to 20 ft., From ft. to ft.  
 From ft. to ft., From ft. to ft.

6 GROUT MATERIAL: 1 Neat cement 2 Cement grout  3 Bentonite 4 Other  
 Grout Intervals: From 20 ft. to 0 ft., From ft. to ft., From ft. to ft.  
 What is the nearest source of possible contamination: NONE AT THE TIME  
 1 Septic tank  4 Lateral lines  7 Pit privy  10 Livestock pens  14 Abandoned water well  
 2 Sewer lines  5 Cess pool  8 Sewage lagoon  11 Fuel storage  15 Oil well/Gas well  
 3 Watertight sewer lines  6 Seepage pit  9 Feedyard  12 Fertilizer storage  16 Other (specify below)  
 13 Insecticide storage  
 Direction from well? How many feet?

FROM	TO	LITHOLOGIC LOG	FROM	TO	PLUGGING INTERVALS
0	15	Soil + Clay			
15	29	Sand + Clay - wet			
29	44	Lime			
44	53	Shale			
53	62	Sand - Light grey			
62	100	Shale			

7 CONTRACTOR'S OR LANDOWNER'S CERTIFICATION: This water well was  (1) constructed, (2) reconstructed, or (3) plugged under my jurisdiction and was completed on (mo/day/year) 12-12-94 and this record is true to the best of my knowledge and belief. Kansas Water Well Contractor's License No. 561 This Water Well Record was completed on (mo/day/yr) 12-26-94 under the business name of EVANS ENERGY Dev. Inc. by (signature) [Signature]