


1 LOCATION OF WATER WELL: County: Franklin Fraction NE 1/4 SW 1/4 NW Section Number 15 Township Number T 17 S Range Number R 21 EW

Distance and direction from nearest town or city street address of well if located within city? 2 miles NE of Rantoul Ks.

2 WATER WELL OWNER: Oaks Petroleum RR#, St. Address, Box #: Rt 3 Box 346 City, State, ZIP Code: Paola Ks 66071 Board of Agriculture, Division of Water Resources Application Number: 38,370

3 LOCATE WELL'S LOCATION WITH AN "X" IN SECTION BOX:

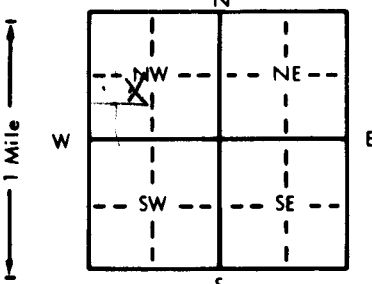

4 DEPTH OF COMPLETED WELL: 100 ft. ELEVATION: 875

Depth(s) Groundwater Encountered 1. ft. 2. ft. 3. ft. WELL'S STATIC WATER LEVEL ft. below land surface measured on mo/day/yr Pump test data: Well water was ft. after hours pumping gpm Est. Yield gpm Well water was ft. after hours pumping gpm Bore Hole Diameter 10 in. to 41 ft. and 8 in. to 100 ft. WELL WATER TO BE USED AS: 5 Public water supply 8 Air conditioning 11 Injection well 1 Domestic 3 Feedlot 6 Oil field water supply 9 Dewatering 12 Other (Specify below) 2 Irrigation 4 Industrial 7 Lawn and garden only 10 Observation well Was a chemical/bacteriological sample submitted to Department? Yes No X; If yes, mo/day/yr sample was submitted Water Well Disinfected? Yes No

5 TYPE OF BLANK CASING USED: 1 Steel 3 RMP (SR) 5 Wrought iron 8 Concrete tile CASING JOINTS: Glued Clamped 2 PVC 4 ABS 6 Asbestos-Cement 9 Other (specify below) Welded X 3 Fiberglass Threaded

Blank casing diameter 8 in. to 36 ft. Dia in. to ft. Dia in. to ft. Casing height above land surface 36 in., weight lbs./ft. Wall thickness or gauge No.

TYPE OF SCREEN OR PERFORATION MATERIAL: 1 Steel 3 Stainless steel 5 Fiberglass 8 RMP (SR) 10 Asbestos-cement 2 Brass 4 Galvanized steel 6 Concrete tile 9 ABS 11 Other (specify) 12 None used (open hole)

SCREEN OR PERFORATION OPENINGS ARE: 1 Continuous slot 3 Mill slot 5 Gauzed wrapped 8 Saw cut 11 None (open hole) 2 Louvered shutter 4 Key punched 6 Wire wrapped 9 Drilled holes 7 Torch cut 10 Other (specify)

SCREEN-PERFORATED INTERVALS: From ft. to ft. From ft. to ft. GRAVEL PACK INTERVALS: From 13 ft. to 100 ft. From ft. to ft. From ft. to ft.

6 GROUT MATERIAL: 1 Neat cement 2 Cement grout 3 Bentonite 4 Other Grout Intervals: From 3 ft. to 13 ft. From ft. to ft. From ft. to ft.

What is the nearest source of possible contamination: 1 Septic tank 4 Lateral lines 7 Pit privy 10 Livestock pens 14 Abandoned water well 2 Sewer lines 5 Cess pool 8 Sewage lagoon 11 Fuel storage 15 Oil well Gas well 3 Watertight sewer lines 6 Seepage pit 9 Feedyard 12 Fertilizer storage 16 Other (specify below) 13 Insecticide storage Direction from well? NE How many feet? 65'

FROM	TO	LITHOLOGIC LOG	FROM	TO	LITHOLOGIC LOG
		Soil	0	2	
		SILT +	2	8	
		Quick sand	8	24	
		Sandy SILT	24	36	
		River Gravel	36	41	
		Shale	41	58	
		Lime	58	64	
		Shale	64	78	
		Shale	78	84	
		Lime	84	97	
			97	100	T.D.

7 CONTRACTOR'S OR LANDOWNER'S CERTIFICATION: This water well was (1) constructed, (2) reconstructed, or (3) plugged under my jurisdiction and was completed on (mo/day/year) 5-5-87 and this record is true to the best of my knowledge and belief. Kansas Water Well Contractor's License No. 338 This Water Well Record was completed on (mo/day/yr) 5-6-87 under the business name of Jayhawk Drilling by (signature) Thomas F. Maylan

INSTRUCTIONS: Use typewriter or ball point pen, PLEASE PRESS FIRMLY and PRINT clearly. Please fill in blanks, underline or circle the correct answers. Send top three copies to Kansas Department of Health and Environment, Division of Environment, Environmental Geology Section, Topeka, KS 66620. Send one to WATER WELL OWNER and retain one for your records.