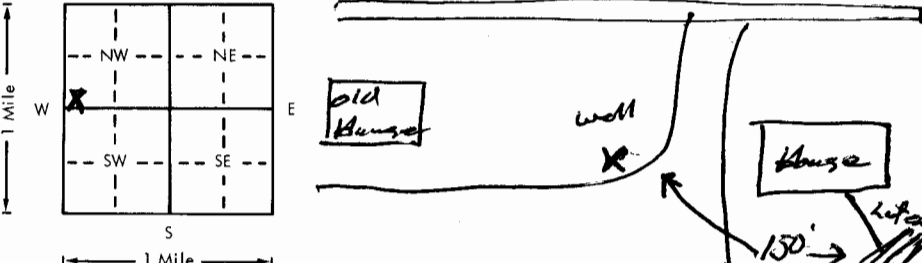


USE TYPEWRITER OR BALL POINT PEN-PRESS FIRMLY, PRINT CLEARLY.

WATER WELL RECORD
KSA 82a-1201-1215

Kansas Department of Health and Environment-Division of Environment
(Water well Contractors)
Topeka, Kansas 66620

1. Location of well: County <u>Franklin</u> Fraction <u>SW 1/4 SW 1/4 NW 1/4</u> Section number <u>27</u> Township number <u>T 17 S R 21</u> Range number <u>21</u>	
2. Distance and direction from nearest town or city: <u>1 E 1/2 S</u> Street address of well location if in city: <u>Rantoul</u> 3. Owner of well: <u>Owen C. Manson</u> R.R. or street: <u>RR #1</u> City, state, zip code: <u>Rantoul, Ks. 66079</u>	
4. Locate with "X" in section below: Sketch map: 	
5. Type and color of material	
	From To
<u>Top Soil</u>	<u>0 4</u>
<u>Gray Clay</u>	<u>4 6</u>
<u>Tan Clay</u>	<u>6 18</u>
<u>Yellow Sandy Clay</u>	<u>18 23</u>
<u>Brown large Flint-Chert Gravel</u>	<u>23 26</u>
<u>Gray Limestone</u>	<u>26 40</u>
6. Bore hole dia. <u>10</u> in. Completion date <u>9-15-78</u> Well depth <u>40</u> ft.	
7. <input checked="" type="checkbox"/> Cable tool <input checked="" type="checkbox"/> Rotary <input type="checkbox"/> Driven <input type="checkbox"/> Dug <input type="checkbox"/> Hollow rod <input type="checkbox"/> Jetted <input type="checkbox"/> Bored <input type="checkbox"/> Reverse rotary	
8. Use: <input checked="" type="checkbox"/> Domestic <input type="checkbox"/> Public supply <input type="checkbox"/> Industry <input type="checkbox"/> Irrigation <input type="checkbox"/> Air conditioning <input type="checkbox"/> Stock <input type="checkbox"/> Lawn <input type="checkbox"/> Oil field water <input type="checkbox"/> Other	
9. Casing: Material <u>PVC</u> Height <u>Above</u> or below Threaded <input type="checkbox"/> Welded <input type="checkbox"/> Surface <u>74</u> in. RMP <input type="checkbox"/> PVC <u>Clue</u> Weight <u>2.74</u> lbs./ft. Dia. <u>5</u> in. to <u>40</u> ft. depth Wall Thickness: inches or Dia. <u>5</u> in. to <u>40</u> ft. depth gage No. <u>128</u>	
10. Screen: Manufacturer's name <u>Pumpco</u> Type <u>PVC</u> Dia. <u>5"</u> Slot/gauge <u>020</u> Length <u>10'</u> Set between <u>20</u> ft. and <u>30</u> ft. <u>20</u> ft. and <u>30</u> ft. Gravel pack? <u>YES</u> Size range of material <u>020/060</u>	
11. Static water level: <u>15</u> ft. below land surface Date <u>9-15-78</u> mo./day/yr.	
12. Pumping level below land surfaces: <u>11-15</u> <u>15</u> ft. after <u>1</u> hrs. pumping <u>3</u> g.p.m. <u>15</u> ft. after <u>1</u> hrs. pumping <u>3</u> g.p.m. Estimated maximum yield <u>3</u> g.p.m.	
13. Water sample submitted: <u>X</u> Yes <u>15-78</u> No Date	
14. Well head completion: <u>Top Cap</u> <u>24</u> Pitless adapter <u>24</u> Inches above grade	
15. Well grouted? <u>YES</u> With: <input checked="" type="checkbox"/> Neat cement <input type="checkbox"/> Bentonite <input type="checkbox"/> Concrete Depth: From <u>0</u> ft. to <u>10</u> ft.	
16. Nearest source of possible contamination: <u>150</u> ft. Direction <u>SW</u> Type <u>Leak</u> Well disinfected upon completion? <input checked="" type="checkbox"/> Yes <input type="checkbox"/> No	
17. Pump: <u>X</u> Not installed Manufacturer's name _____ Model number _____ HP _____ Volts _____ Length of drop pipe _____ ft. capacity _____ g.p.m. Type: _____ <input type="checkbox"/> Submersible <input type="checkbox"/> Turbine <input type="checkbox"/> Jet <input type="checkbox"/> Reciprocating <input type="checkbox"/> Centrifugal <input type="checkbox"/> Other	
(Use a second sheet if needed)	
18. Elevation: Topography: <input type="checkbox"/> Hill <input type="checkbox"/> Slope <input type="checkbox"/> Upland <input checked="" type="checkbox"/> Valley	19. Remarks: <u>owner to install slab</u>
20. Water well contractor's certification: This well was drilled under my jurisdiction and this report is true to the best of my knowledge and belief. <u>STRODER DRIG CO</u> <u>182</u> Business name License No. Address <u>RT 1 Holton, KS</u> Signed <u>Dale Ashen</u> Date <u>9-22-78</u> Authorized representative	

T 17 S R 21 E 27
 SUSUNO
 1/4 1/4 1/4