


1 LOCATION OF WATER WELL:
 County: Miami Fraction SW 1/4 NW 1/4 NW 1/4 Section Number 15 Township Number 17 Range Number 22 E/W
 Distance and direction from nearest town or city street address of well if located within city?

2 WATER WELL OWNER: E. Everett + Leona Oyster Trust
 RR#, St. Address, Box #: 32051 W 303
 City, State ZIP Code: Paoli, KS 66071
Global Positioning Systems (decimal degrees, min. of 4 digits)
 Latitude: _____
 Longitude: _____
 Elevation: _____
 Datum: _____
 Data Collection Method: _____

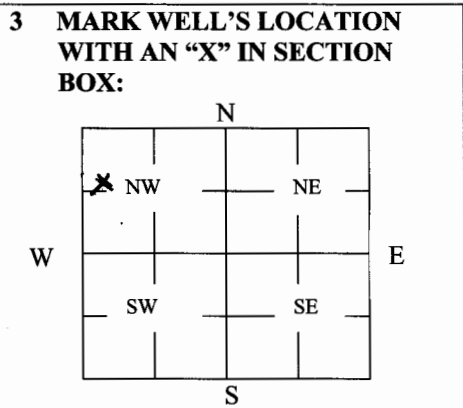

4 DEPTH OF WELL _____ **ft.**
 WELL'S STATIC WATER LEVEL _____ ft
 WELL WAS USED AS:
 1 Domestic 5 Public Water Supply 9 Dewatering
 2 Irrigation 6 Oil Field Water Supply 10 Monitoring
 3 Feedlot 7 Domestic (Lawn & Garden) 11 Injection Well
 4 Industrial 8 Air Conditioning 12 Other _____
 Was a chemical/bacteriological sample submitted to Department? Yes _____ No

5 TYPE OF BLANK CASING USED:
 1 Steel 3 RMP (SR) 5 Wrought 7 Fiberglass 9 Other (Specify below)
 2 PVC 4 ABS 6 Asbestos-Cement 8 Concrete Tile
 Blank casing diameter 8 in. Was casing pulled? Yes _____ No If yes, how much _____
 Casing height above or below land surface _____ in. Cut off 42"

6 GROUT PLUG MATERIAL: 1 Neat cement 2 Cement grout 3 Bentonite 4 Other _____
 Grout Plug Intervals: From 45 ft. to 0 ft., From _____ ft. to _____ ft., From _____ to _____ ft.
 What is the nearest source of possible contamination:
 1 Septic tank 6 Seepage pit 11 Fuel Storage 16 Other (specify below)
 2 Sewer lines 7 Pit privy 12 Fertilizer storage In urban neighborhood
 3 Watertight sewer lines 8 Sewage lagoon 13 Insecticide storage Well ~~under~~ near road house
 4 Lateral lines 9 Feedyard 14 Abandoned water well Direction from well? East of porch
 5 Cess pool 10 Livestock pens 15 Oil well/Gas well How many feet? 3 feet

FROM	TO	PLUGGING MATERIALS	FROM	TO	PLUGGING MATERIALS
45'	0'	bentonite clay			

7 CONTRACTOR'S OR LANDOWNER'S CERTIFICATION: This water well was plugged under my jurisdiction and was completed on (mo/day/year) 8/4/2006 and this record is true to the best of my knowledge and belief. Kansas Water Well Contractor's License No. N.A. This Water Well Record was completed on (mo/day/year) _____ under the business name of landowner E. Everett Oyster by (signature) _____