


mw-1

1 LOCATION OF WATER WELL: County: **Miami** Fraction: **SW**  $\frac{1}{4}$  **SE**  $\frac{1}{4}$  **NE**  $\frac{1}{4}$  Section Number: **9** Township Number: **T 17 S** Range Number: **R 23 EW**

Distance and direction from nearest town or city street address of well if located within city?  
**EZ Shop #18, 602 N. Pearl, Paola, Kansas**

2 WATER WELL OWNER: **EZ Shop #18**  
 RR#, St. Address, Box #: **602 N. Pearl, Paola, Kansas**  
 City, State, ZIP Code: **Paola, Kansas**  
 Board of Agriculture, Division of Water Resources  
 Application Number: **-----**

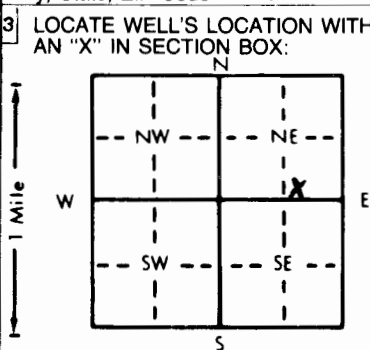

4 DEPTH OF COMPLETED WELL: **25** ft. ELEVATION: **-----**  
 Depth(s) Groundwater Encountered: 1. **22** ft. 2. ~~15~~ ft. 3. **-----** ft.  
 WELL'S STATIC WATER LEVEL: **11.38** ft. below land surface measured on mo/day/yr: **6-7-97**  
 Pump test data: Well water was **-----** ft. after **-----** hours pumping **-----** gpm  
 Est. Yield **-----** gpm: Well water was **-----** ft. after **-----** hours pumping **-----** gpm  
 Bore Hole Diameter: **8.625** in. to **25** ft., and **-----** in. to **-----** ft.  
 WELL WATER TO BE USED AS:  
 1 Domestic  3 Feedlot  6 Oil field water supply  9 Dewatering  12 Other (Specify below)   
 2 Irrigation  4 Industrial  7 Lawn and garden only  **10 Monitoring well**  **mw-2**  
 Was a chemical/bacteriological sample submitted to Department? Yes  No  **X**; If yes, mo/day/yr sample was submitted **-----**  
 Water Well Disinfected? Yes  No  **X**

5 TYPE OF BLANK CASING USED:  
 1 Steel  3 RMP (SR)  5 Wrought iron  8 Concrete tile  CASING JOINTS: Glued  Clamped   
 2 PVC  4 ABS  6 Asbestos-Cement  9 Other (specify below)  Welded   
 7 Fiberglass  Threaded  **X**  
 Blank casing diameter: **2** in. to **15** ft., Dia. **-----** in. to **-----** ft., Dia. **-----** in. to **-----** ft.  
 Casing height above land surface: **0** in., weight **SCH 40 PVC** lbs./ft. Wall thickness or gauge No. **-----**  
 TYPE OF SCREEN OR PERFORATION MATERIAL:  
 1 Steel  3 Stainless steel  5 Fiberglass  8 RMP (SR)  10 Asbestos-cement   
 2 Brass  4 Galvanized steel  6 Concrete tile  9 ABS  11 Other (specify)   
 12 None used (open hole)   
 SCREEN OR PERFORATION OPENINGS ARE:  
 1 Continuous slot  3 Mill slot  5 Gauzed wrapped  8 Saw cut  11 None (open hole)   
 2 Louvered shutter  4 Key punched  6 Wire wrapped  9 Drilled holes   
 7 Torch cut  10 Other (specify)   
 SCREEN-PERFORATED INTERVALS: From **15** ft. to **25** ft., From **-----** ft. to **-----** ft., From **-----** ft. to **-----** ft.  
 From **-----** ft. to **-----** ft., From **-----** ft. to **-----** ft., From **-----** ft. to **-----** ft.  
 GRAVEL PACK INTERVALS: From **14** ft. to **25** ft., From **-----** ft. to **-----** ft., From **-----** ft. to **-----** ft.  
 From **-----** ft. to **-----** ft., From **-----** ft. to **-----** ft., From **-----** ft. to **-----** ft.

6 GROUT MATERIAL: 1 Neat cement  2 Cement grout  3 Bentonite  4 Other   
 Grout Intervals: From **20** ft. to **12** ft., From **3** ft. to **12** ft., From **14** ft. to **-----** ft., From **-----** ft. to **-----** ft.  
 What is the nearest source of possible contamination:  
 1 Septic tank  4 Lateral lines  7 Pit privy  10 Livestock pens  14 Abandoned water well   
 2 Sewer lines  5 Cess pool  8 Sewage lagoon  11 Fuel storage  15 Oil well/Gas well   
 3 Watertight sewer lines  6 Seepage pit  9 Feedyard  12 Fertilizer storage  16 Other (specify below)  **Contaminated Si**  
 13 Insecticide storage   
 Direction from well? How many feet? **-----**

FROM	TO	LITHOLOGIC LOG	FROM	TO	PLUGGING INTERVALS
<b>GL</b>	<b>0.50</b>	<b>Concrete</b>			
<b>0.50</b>	<b>4.50</b>	<b>Fill Material</b>			
<b>4.50</b>	<b>5.50</b>	<b>Silty Clay (CL)</b>			
<b>5.50</b>	<b>14.00</b>	<b>Fill Sand, Limestone</b>			
<b>14.00</b>	<b>16.50</b>	<b>Limestone</b>			
<b>16.50</b>	<b>18.00</b>	<b>Shale</b>			
<b>18.00</b>	<b>TD</b>	<b>End of Borehole</b>			

7 CONTRACTOR'S OR LANDOWNER'S CERTIFICATION: This water well was (1) constructed, (2) reconstructed, or (3) plugged under my jurisdiction and was completed on (mo/day/year) **5-13-97** and this record is true to the best of my knowledge and belief. Kansas Water Well Contractor's License No. **585** This Water Well Record was completed on (mo/day/yr) **6-25-97** under the business name of **ALI** by (signature) **Stephen J. P. Penca**

INSTRUCTIONS: Use typewriter or ball point pen. PLEASE PRESS FIRMLY and PRINT clearly. Please fill in blanks, underline or circle the correct answers. Send top three copies to Kansas Department of Health and Environment, Bureau of Water, Topeka, Kansas 66620-0001. Telephone: 913-296-5545. Send one to WATER WELL OWNER and retain one for your records.

OFFICE USE ONLY T R EW SEC 1/4 1/4 1/4