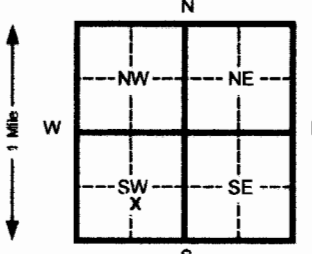
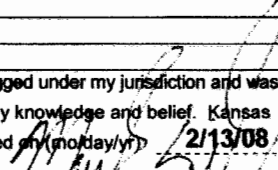


1 LOCATION OF WATER WELL: County: Miami		Fraction SW ¼ SW ¼ SE ¼	Section Number 09	Township Number T 17 S	Range Number R 23 EW
Distance and direction from nearest town or city street address of well if located within city? 1005 N Pearl, Paola Kansas					
2 WATER WELL OWNER: Scott Zaremba RR#, St. Address, Box # : 718 E. 1300 Rd City, State, ZIP Code : Lawrence, Kansas, 66046 Board of Agriculture, Division of Water Resources Application Number:					
3 LOCATE WELL'S LOCATION WITH AN "X" IN SECTION BOX: 		4 DEPTH OF COMPLETED WELL 5.0 ft. ELEVATION: Depth(s) Groundwater Encountered 1 NA ft. 2 _____ ft. 3 _____ ft. WELL'S STATIC WATER LEVEL NA ft. below land surface measured on mo/day/yr 2/13/08 Pump test data: Well water was _____ ft. after _____ hours pumping _____ gpm Est. Yield NA gpm: Well water was _____ ft. after _____ hours pumping _____ gpm Bore Hole Diameter 8.5 in. to _____ ft. and _____ in. to _____ ft. WELL WATER TO BE USED AS: 5 Public water supply 8 Air conditioning 11 Injection well 1 Domestic 3 Feed lot 6 Oil field water supply 9 Dewatering 12 Other (Specify below) 2 Irrigation 4 Industrial 7 Lawn and garden (domestic) 10 Monitoring well Was a chemical/bacteriological sample submitted to Department? Yes _____ No X If yes, mo/day/yr sample was submitted Water Well Disinfected? Yes _____ No X			
5 TYPE OF BLANK CASING USED: 1 Steel 3 RMP (SR) 5 Wrought Iron 8 Concrete tile CASING JOINTS: Glued _____ Clamped _____ 2 PVC 4 ABS 6 Asbestos-Cement 9 Other (specify below) Welded _____ 7 Fiberglass _____ Threaded X Blank casing diameter 2.375 in. to _____ ft., Dia _____ in. to _____ ft., Dia _____ in. to _____ ft. Casing height above land surface Flush Mount in., weight _____ lbs./ft. Wall thickness or gauge No. Schedule 40 TYPE OF SCREEN OR PERFORATION MATERIAL: 1 Steel 3 Stainless steel 5 Fiberglass 7 PVC 10 Asbestos-cement 2 Brass 4 Galvanized steel 6 Concrete tile 8 RMP (SR) 11 Other (specify) _____ 9 ABS 12 None used (open hole) _____ SCREEN OR PERFORATION OPENINGS ARE: 1 Continuous slot 3 Mill slot 5 Gauzed wrapped 8 Saw cut 11 None (open hole) 2 Louvered shutter 4 Key punched 6 Wire wrapped 9 Drilled holes 7 Torch cut 10 Other (specify) _____ SCREEN-PERFORATED INTERVALS: From 3 ft. to 5.0 ft. From _____ ft. to _____ ft. GRAVEL PACK INTERVALS: From 2.0 ft. to 5.0 ft. From _____ ft. to _____ ft. From _____ ft. to _____ ft. From _____ ft. to _____ ft.					
6 GROUT MATERIAL: 1 Neat cement 2 Cement grout 3 Bentonite 4 Other Grout intervals From 0.0 ft. to 1.0 ft. From 1.0 ft. to 2.0 ft. From _____ ft. to _____ ft. What is the nearest source of possible contamination: 1 Septic tank 4 Lateral lines 7 Pit privy 10 Livestock pens 14 Abandoned water well 2 Sewer lines 5 Cess pool 8 Sewage lagoon 11 Fuel storage (former) 15 Oil well/ Gas well 3 Watertight sewer lines 6 Seepage pit 9 Feedyard 12 Fertilizer storage 16 Other (specify below) _____ 13 Insecticide storage _____ Direction from well? NA How many feet? 0					
FROM		TO		CODE	
0.0		0.5		Asphalt	
.5		4.9		Red Brown Clay Fat silty clay, stiff	
4.9		5.0		Refusal at 5.0 Limestone	
Flush-mount well completion waiver existent for site.					
7 CONTRACTOR'S OR LANDOWNER'S CERTIFICATION: This water well was 1 constructed, (2) reconstructed, or (3) plugged under my jurisdiction and was completed on (mo/day/yr) 02/12/08 and this record is true to the best of my knowledge and belief. Kansas Water Well Contractor's License No. 692 This Water Well Record was completed on (mo/day/yr) 2/13/08 under the business name of Quad State Services, Inc. by (signature) 					
INSTRUCTIONS: Please fill in blanks and circle the correct answers. Send three copies to Kansas Department of Health and Environment, Bureau of Water, 1000 SW Jackson St., Ste. 420, Topeka, Kansas 66612-1367. Telephone: 913-296-5545. Send one to WATER WELL OWNER and retain one for your records.					

OFFICE USE ONLY

T

R

SEC