

CORRECTION(S) TO WATER WELL RECORD (WWC-5)  
(to rectify lacking or incorrect information)

County: Miami

Location listed as:

Location changed to:

Section-Township-Range: 1-17-24E

1-17-24E

Fraction (1/4 1/4 1/4): NW NE NW

S2 SW SE NW

Other changes: Initial statements: \_\_\_\_\_

Changed to: \_\_\_\_\_

Comments: owner name is DON not Dan  
well was mis-placed (too far north)

verification method: phone call with Mr Ryden's neighbor.  
KGS WWC-5 interactive mapper.


initials: AK date: 4/25/2012

submitted by: Kansas Geological Survey, Data Resources Library, 1930 Constant Ave., Lawrence, KS 66047-3726  
to: Kansas Dept of Health & Environment, Bureau of Water, 1000 SW Jackson, Suite 420, Topeka, KS 66612-1367.

1 LOCATION OF WATER WELL: County: Miami Fraction: NW 1/4 NE 1/4 NW 1/4 Section Number: 1 Township Number: T 17 S Range Number: R 24 E/W

Distance and direction from nearest town or city street address of well if located within city?  
29085 Oxford

2 WATER WELL OWNER: Don Ryden  
RR#, St. Address, Box #: 29085 Oxford Board of Agriculture, Division of Water Resources  
City, State, ZIP Code: Louisburg, KS 66053 Application Number:

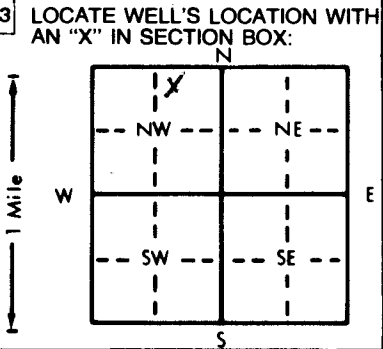

4 DEPTH OF COMPLETED WELL: 208 ft. ELEVATION: ..... ft.  
Depth(s) Groundwater Encountered 1. 98-104 ft. 2. 150 ft. 3. .... ft.  
WELL'S STATIC WATER LEVEL: 15' ft. below land surface measured on mo/day/yr 6/3/98  
Pump test data: Well water was ..... ft. after ..... hours pumping ..... gpm  
Est. Yield: 3 1/2 gpm: Well water was ..... ft. after ..... hours pumping ..... gpm  
Bore Hole Diameter: 10 in. to 208 ft., and ..... in. to ..... ft.  
WELL WATER TO BE USED AS:  
 1 Domestic     3 Feedlot     6 Oil field water supply     9 Dewatering     12 Other (Specify below)  
 2 Irrigation     4 Industrial     7 Lawn and garden only     10 Monitoring well  
 Was a chemical/bacteriological sample submitted to Department? Yes.....No .....; If yes, mo/day/yr sample was submitted  
 Water Well Disinfected? Yes  No

5 TYPE OF BLANK CASING USED:  
 1 Steel     3 RMP (SR)     5 Wrought iron     8 Concrete tile    CASING JOINTS: Glued  Clamped .....  
 2 PVC     4 ABS     6 Asbestos-Cement     9 Other (specify below)    Welded .....  
 7 Fiberglass    Threaded .....  
 Blank casing diameter: 5 in. to 208 ft., Dia ..... in. to ..... ft., Dia ..... in. to ..... ft.  
 Casing height above land surface: 18 in., weight ..... lbs./ft. Wall thickness or gauge No. Sch. 40  
 TYPE OF SCREEN OR PERFORATION MATERIAL:  
 1 Steel     3 Stainless steel     5 Fiberglass     7 PVC     10 Asbestos-cement  
 2 Brass     4 Galvanized steel     6 Concrete tile     8 RMP (SR)     11 Other (specify) .....  
 12 None used (open hole)  
 SCREEN OR PERFORATION OPENINGS ARE:  
 1 Continuous slot     3 Mill slot     5 Gauzed wrapped     8 Saw cut     11 None (open hole)  
 2 Louvered shutter     4 Key punched     6 Wire wrapped     9 Drilled holes  
 7 Torch cut     10 Other (specify) .....  
 SCREEN-PERFORATED INTERVALS: From 140 ft. to 180 ft., From 80 ft. to 100 ft.  
 GRAVEL PACK INTERVALS: From 30 ft. to 208 ft., From ..... ft. to ..... ft.

6 GROUT MATERIAL:  1 Neat cement     2 Cement grout     3 Bentonite     4 Other .....  
 Grout Intervals: From 0 ft. to 30 ft., From ..... ft. to ..... ft., From ..... ft. to ..... ft.  
 What is the nearest source of possible contamination:  
 1 Septic tank     4 Lateral lines     7 Pit privy     10 Livestock pens     14 Abandoned water well  
 2 Sewer lines     5 Cess pool     8 Sewage lagoon     11 Fuel storage     15 Oil well/Gas well  
 3 Watertight sewer lines     6 Seepage pit     9 Feedyard     12 Fertilizer storage     16 Other (specify below)  
 13 Insecticide storage  
 Direction from well? How many feet? 100'

FROM	TO	LITHOLOGIC LOG	FROM	TO	PLUGGING INTERVALS
0	8	Clay			
8	24	Limestone (Brown, Bkn.)			
24	78	Shale			
78	86	Limestone (Brown)			
86	88	Gray Sandstone			
88	98	Gray Shale			
98	104	Gray Sandstone (Water)			
104	109	Dark Gray Shale			
109	146	Light Gray Shale			
146	180	Limestone (Brown) (Water)			
180	190	Gray Sandstone			
190	208	Shale			

7 CONTRACTOR'S OR LANDOWNER'S CERTIFICATION: This water well was  (1) constructed, (2) reconstructed, or (3) plugged under my jurisdiction and was completed on (mo/day/year) 6/3/98 and this record is true to the best of my knowledge and belief. Kansas Water Well Contractor's License No. 595 This Water Well Record was completed on (mo/day/yr) 7/10/98 under the business name of Jesse Yankum Well Drilling by (signature) Jesse Ryden

INSTRUCTIONS: Use typewriter or ball point pen. PLEASE PRESS FIRMLY and PRINT clearly. Please fill in blanks, underline or circle the correct answers. Send top three copies to Kansas Department of Health and Environment, Bureau of Water, Topeka, Kansas 66620-0001. Telephone: 913-296-5545. Send one to WATER WELL OWNER and retain one for your records.