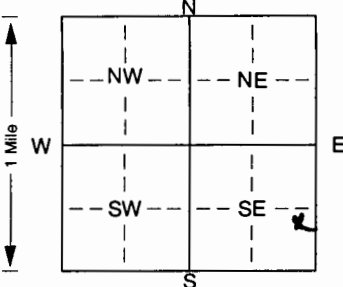


1 LOCATION OF WATER WELL: Fraction NE 1/4 SE 1/4 SE 1/4 Section Number 2 Township Number T 17 S Range Number R 3 E/W
 County: Marion

Distance and direction from nearest town or city street address of well if located within city?
NO 8 E 3rd Ramona KS

2 WATER WELL OWNER: Ramona Senior Citizen Center Attn: Kim Antoszyk RG MW-3
 RR#, St. Address, Box #: PO Box 73 Board of Agriculture, Division of Water Resources
 City, State, ZIP Code: Ramona, KS 67475 Application Number:

3 LOCATE WELL'S LOCATION WITH AN "X" IN SECTION BOX:

 4 DEPTH OF COMPLETED WELL: 43.0 ft. ELEVATION: 1418.50
 Depth(s) Groundwater Encountered 1. 40.0 ft. 2. . ft. 3. . ft.
 WELL'S STATIC WATER LEVEL ft. below land surface measured on mo/day/yr
 Pump test data: Well water was ft. after hours pumping gpm
 Est. Yield gpm: Well water was ft. after hours pumping gpm
 Bore Hole Diameter. in. to ft., and in. to ft.
 WELL WATER TO BE USED AS: 5 Public water supply 8 Air conditioning 11 Injection well
 1 Domestic 3 Feedlot 6 Oil field water supply 9 Dewatering 12 Other (Specify below)
 2 Irrigation 4 Industrial 7 Domestic (lawn & garden) 10 Monitoring well
 Was a chemical/bacteriological sample submitted to Department? Yes. No. X; If yes, mo/day/yr sample was submitted
 Water Well Disinfected? Yes No X

5 TYPE OF BLANK CASING USED:
 1 Steel 3 RMP (SR) 5 Wrought iron 8 Concrete tile CASING JOINTS: Glued. Clamped.
2 PVC 4 ABS 6 Asbestos-Cement 9 Other (specify below) Welded
 Blank casing diameter 2 in. to ft., Dia in. to ft., Dia in. to ft.
 Casing height above land surface. in., weight lbs./ft. Wall thickness or gauge No.
 TYPE OF SCREEN OR PERFORATION MATERIAL:
 1 Steel 3 Stainless steel 5 Fiberglass 7 PVC 10 Asbestos-cement
 2 Brass 4 Galvanized steel 6 Concrete tile 8 RMP (SR) 11 Other (specify)
 12 None used (open hole)
 SCREEN OR PERFORATION OPENINGS ARE:
 1 Continuous slot 3 Mill slot 5 Gauzed wrapped 8 Saw cut 11 None (open hole)
 2 Louvered shutter 4 Key punched 6 Wire wrapped 9 Drilled holes
 7 Torch cut 10 Other (specify) ft.
 SCREEN-PERFORATED INTERVALS: From 27.5 ft. to 43 ft., From ft. to ft.
 GRAVEL PACK INTERVALS: From 25 ft. to 43 ft., From ft. to ft.

6 GROUT MATERIAL: 1 Neat cement 2 Cement grout 3 Bentonite 4 Other
 Grout Intervals: From 3 ft. to 25.5 ft., From ft. to ft., From ft. to ft.
 What is the nearest source of possible contamination:
 1 Septic tank 4 Lateral lines 7 Pit privy 10 Livestock pens 14 Abandoned water well
 2 Sewer lines 5 Cess pool 8 Sewage lagoon 11 Fuel storage 15 Oil well/Gas well
 3 Watertight sewer lines 6 Seepage pit 9 Feedyard 12 Fertilizer storage 16 Other (specify below)
 13 Insecticide storage
 Direction from well? How many feet?

FROM	TO	LITHOLOGIC LOG	FROM	TO	PLUGGING INTERVALS
0	4	Med stiff, damp, gray-black, slightly sandy clay			
4.0	6.0	Same, grades to med brn silty clay			
6.0	9.0	Med stiff, damp, med orange-brn silty clay friable			
9.0	14.0	same, mainly clayey silt			
14.0	19.0	semi-cons, damp, med brn-yellow clayey silt			
19.0	24.0	same as above, clayey silt - silty clay			
24.0	29.0	same, grades to light gray			
29.0	34.0	same, yellow-brn			
34.0	39.0	semi-cons, moist light gray silty clay on shale			
39.0	44.0	semi-cons, moist to wet gray shale friable			

7 CONTRACTOR'S OR LANDOWNER'S CERTIFICATION: This water well was (1) constructed, (2) reconstructed, or (3) plugged under my jurisdiction and was completed on (mo/day/year) 9/20/01 and this record is true to the best of my knowledge and belief. Kansas Water Well Contractor's Licence No. 614 This Water Well Record was completed on (mo/day/yr) 11/6/01 under the business name of Maxim Technologies by (signature) William Stafford