


1 LOCATION OF WATER WELL: Fraction **SE ¼ SE ¼ SE ¼** Section Number **2** Township Number **T 17 N 8** Range Number **R 3 E/W**
 County: **Marion**

Distance and direction from nearest town or city street address of well if located within city?

2 WATER WELL OWNER: **USDA/CCC**
 RR#, St. Address, Box #: **Stop 0513, Room 4717-S/ 1400 Independence Ave SW** Board of Agriculture, Division of Water Resources
 City, State, ZIP Code: **Washington, DC 20250-0513** Application Number:

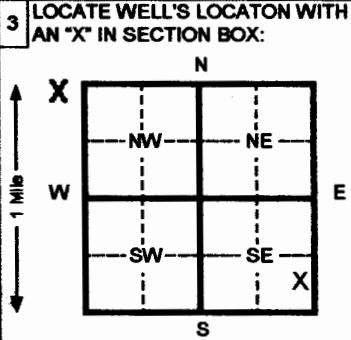

4 DEPTH OF COMPLETED WELL **55.6** ft. ELEVATION: **1,436.955'**
 Depth(s) Groundwater Encountered 1 **50** ft. 2 ft. 3 ft.
 WELL'S STATIC WATER LEVEL **49.08** ft. below land surface measured on **10/12/06**
 Pump test data: Well water was **N/A** ft. after **N/A** hours pumping **N/A** gpm
 Est. Yield **N/A** gpm: Well water was **N/A** ft. after **N/A** hours pumping **N/A** gpm
 Bore Hole Diameter **4.25** in. to **21** ft. and **3.5** in. to **55.6** ft.
 WELL WATER TO BE USED AS: 5 Public water supply 8 Air conditioning 11 Injection well
 1 Domestic 3 Feed lot 6 Oil field water supply 9 Dewatering **12 Other (Specify below)**
 2 Irrigation 4 Industrial 7 Lawn and garden (domestic) **10 Monitoring well** **Sand Point MW**
 Was a chemical/bacteriological sample submitted to Department? Yes No **X** If yes, mo/day/yr sample was submitted **N/A**
 Water Well Disinfected? Yes No **X**

5 TYPE OF BLANK CASING USED: 5 Wrought Iron 8 Concrete tile CASING JOINTS: Glued Clamped
 1 Steel 3 RMP (SR) 6 Asbestos-Cement 9 Other (specify below) Welded
2 PVC 4 ABS 7 Fiberglass Threaded **X**
 Blank casing diameter **1"** in. to **45** ft., Dia **N/A** in. to **N/A** ft., Dia **N/A** in. to **N/A** ft.
 Casing height above land surface **Flush Mount** in., weight **Schedule 40** lbs./ft. Wall thickness or gauge No. **.133"**
 TYPE OF SCREEN OR PERFORATION MATERIAL: **7 PVC** 10 Asbestos-cement
 1 Steel 3 Stainless steel 5 Fiberglass 8 RMP (SR) 11 Other (specify)
 2 Brass 4 Galvanized steel 6 Concrete tile 9 ABS 12 None used (open hole)
 SCREEN OR PERFORATION OPENINGS ARE: 5 Gauzed wrapped 8 Saw cut 11 None (open hole)
 1 Continuous slot **3 Mill slot** 6 Wire wrapped 9 Drilled holes
 2 Louvered shutter 4 Key punched 7 Torch cut 10 Other (specify)
 SCREEN-PERFORATED INTERVALS: From **45** ft. to **55** ft. From ft. to ft.
 From ft. to ft. From ft. to ft.
 GRAVEL PACK INTERVALS: From **44** ft. to **55** ft. From ft. to ft.
 From ft. to ft. From ft. to ft.

6 GROUT MATERIAL: 1 Neat cement 2 Cement grout **3 Bentonite** **4 Other BenSeal Chips**
 Grout Intervals From **40 (#3)** ft. to **0.5** ft. From **44 (#4)** ft. to **40** ft. From **N/A** ft. to **N/A** ft.
 What is the nearest source of possible contamination:
1 Septic tank 4 Lateral lines 7 Pit privy 10 Livestock pens 14 Abandoned water well
~~2 Sewer lines~~ 5 Cess pool 8 Sewage lagoon 11 Fuel storage 15 Oil well/ Gas well
 3 Watertight sewer lines 6 Seepage pit 9 Feedyard 12 Fertilizer storage 16 Other (specify below)
 13 Insecticide storage
 Direction from well? How many feet? **400' East**

FROM	TO	CODE	LITHOLOGIC LOG	FROM	TO	PLUGGING INTERVALS
0	2'		Top Soil			
2'	48'		Silt and Clay			
48'	49'		Silty Clay			
49'	50'		Silty Clay with some Sand			
50'	55'		Silty Clay and Sand			
55'	55.6'		Clay and Silt			

7 CONTRACTOR'S OR LANDOWNER'S CERTIFICATION: This water well was **(1) constructed, (2) reconstructed, or (3) plugged** under my jurisdiction and was completed on **09/27/06** and this record is true to the best of my knowledge and belief. Kansas Water Well Contractor's License No. **680** This Water Well Record was completed on **10-13-06** under the business name of **Delta Environmental** by (signature) **[Signature]**