


1] LOCATION OF WATER WELL: Fraction NE 1/4 NE 1/4 SE 1/4 Section Number 14 Township Number T 17 S Range Number R 4 E/W
 County: Marion
 Distance and direction from nearest town or city street address of well if located within city?
1 mile E of 1/2 mile N of Lost Springs

2] WATER WELL OWNER: Greg Kerns
 RR#, St. Address, Box #: Denver Colo.
 City, State, ZIP Code: Denver Colo.
 Board of Agriculture, Division of Water Resources
 Application Number:

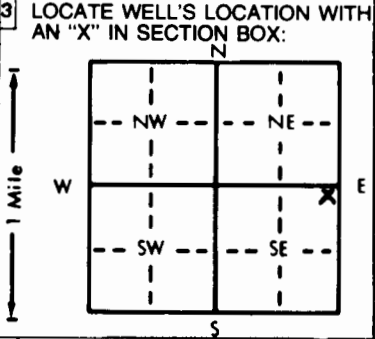

4] DEPTH OF COMPLETED WELL 100 ft. ELEVATION: 46 ft.
 Depth(s) Groundwater Encountered 1. 40 ft. 2. 46 ft. 3. 50 ft.
 WELL'S STATIC WATER LEVEL 40 ft. below land surface measured on mo/day/yr JUN 2 01
 Pump test data: Well water was 20+ ft. after 6 1/2 hours pumping 100 gpm
 Est. Yield 20+ gpm: Well water was 23 ft. after 6 1/2 hours pumping 100 gpm
 Bore Hole Diameter 8 in. to 23 ft. and 6 1/2 in. to 100 ft.
 WELL WATER TO BE USED AS:
 1 Domestic 3 Feedlot 6 Oil field water supply 9 Dewatering 12 Other (Specify below)
 2 Irrigation 4 Industrial 7 Lawn and garden only 10 Monitoring well
 Was a chemical/bacteriological sample submitted to Department? Yes X No X. If yes, mo/day/yr sample was submitted
 Water Well Disinfected? Yes No

5] TYPE OF BLANK CASING USED:
 1 Steel 3 RMP (SR) 6 Asbestos-Cement 9 Other (specify below) CASING JOINTS: Glued X Clamped
 2 PVC 4 ABS 7 Fiberglass 8 Concrete tile 11 Injection well
 Blank casing diameter 5 in. to 40 ft. Dia. 18 in. to SDR26 lbs./ft. Wall thickness or gauge No. SDR26
 Casing height above land surface 18 in., weight SDR26
 TYPE OF SCREEN OR PERFORATION MATERIAL:
 1 Steel 3 Stainless steel 5 Fiberglass 8 RMP (SR) 11 Other (specify)
 2 Brass 4 Galvanized steel 6 Concrete tile 9 ABS 12 None used (open hole)
 SCREEN OR PERFORATION OPENINGS ARE:
 1 Continuous slot 3 Mill slot 5 Gauzed wrapped 8 Saw cut 11 None (open hole)
 2 Louvered shutter 4 Key punched 6 Wire wrapped 9 Drilled holes
 7 Torch cut 10 Other (specify)
 SCREEN-PERFORATED INTERVALS: From 40 ft. to 100 ft. From 40 ft. to 100 ft.
 GRAVEL PACK INTERVALS: From NONE ft. to NONE ft. From NONE ft. to NONE ft.

6] GROUT MATERIAL: 1 Neat cement 2 Cement grout 3 Bentonite 4 Other
 What is the nearest source of possible contamination:
 1 Septic tank 4 Lateral lines 7 Pit privy 10 Livestock pens 14 Abandoned water well
 2 Sewer lines 5 Cess pool 8 Sewage lagoon 11 Fuel storage 15 Oil well/Gas well
 3 Watertight sewer lines 6 Seepage pit 9 Feedyard 12 Fertilizer storage 16 Other (specify below)
 13 Insecticide storage old Pit Silo
 Direction from well? North
 How many feet? 200

FROM	TO	LITHOLOGIC LOG	FROM	TO	PLUGGING INTERVALS
0	4	Top Soil			
4	10	Shale Yel			
10	16	LIME Yel			
16	39	Shales Yel			
39	42	LIME TAN			
42	50	Shale & fine LIME TAN			
50	54	LIME TAN			
54	69	Shale & platy LIME Gray			
69	78	LIME White			
78	90	Shale Gray-green Red			
90	100	LIME White			

7] CONTRACTOR'S OR LANDOWNER'S CERTIFICATION: This water well was (1) constructed, (2) reconstructed, or (3) plugged under my jurisdiction and was completed on (mo/day/year) JUN 2 01 and this record is true to the best of my knowledge and belief. Kansas Water Well Contractor's License No. 218 This Water Well Record was completed on (mo/day/yr) JUN 19 01 under the business name of Zinn Water Well Dring by (signature) [Signature]

INSTRUCTIONS: Use typewriter or ball point pen. PLEASE PRESS FIRMLY and PRINT clearly. Please fill in blanks, underline or circle the correct answers. Send top three copies to Kansas Department of Health and Environment, Bureau of Water, Topeka, Kansas 66620-0001. Telephone: 913-296-5545. Send one to WATER WELL OWNER and retain one for your records.

OFFICE USE ONLY