


1 LOCATION OF WATER WELL: Fraction NW 1/4 NW 1/4 NW 1/4 Section Number 12 Township Number T 17 S Range Number R 4 E/W

Distance and direction from nearest town or city street address of well if located within city?
 1 mile East & 1 1/8 Mile North (on 77 highway) From Lost Springs

2 WATER WELL OWNER: Commercial Construction INC. STATE OF KANSAS
 RR#, St. Address, Box #: P.O. BOX 83558
 City, State, ZIP Code: Lincoln, NE Plugged 68501 77 Highway
 Board of Agriculture, Division of Water Resources Application Number:

3 LOCATE WELL'S LOCATION WITH AN "X" IN SECTION BOX: 4 DEPTH OF COMPLETED WELL: 88 ft. ELEVATION: ? ft.

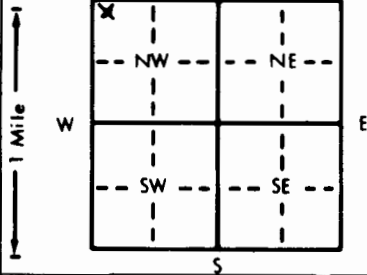

Depth(s) Groundwater Encountered 1. ? ft. 2. ? ft. 3. ? ft.
 WELL'S STATIC WATER LEVEL: 68 ft. below land surface measured on mo/day/yr Jul 30-01
 Pump test data: Well water was ? ft. after ? hours pumping ? gpm
 Est. Yield ? gpm: Well water was ? ft. after ? hours pumping ? gpm
 Bore Hole Diameter ? in. to ? ft., and ? in. to ? ft.
 WELL WATER TO BE USED AS:
 1 Domestic 3 Feedlot 5 Public water supply 8 Air conditioning 11 Injection well
 2 Irrigation 4 Industrial 6 Oil field water supply 9 Dewatering 12 Other (Specify below)
 7 Lawn and garden only 10 Monitoring well
 Was a chemical/bacteriological sample submitted to Department? Yes.....No.....; If yes, mo/day/yr sample was submitted
 Water Well Disinfected? Yes No

5 TYPE OF BLANK CASING USED:
 1 Steel 3 RMP (SR) 5 Wrought iron 8 Concrete tile CASING JOINTS: Glued.....Clamped.....
 2 PVC 4 ABS 6 Asbestos-Cement 9 Other (specify below) Welded.....
 7 Fiberglass Threaded.....

Blank casing diameter ? in. to ? ft., Dia ? in. to ? ft., Dia ? in. to ? ft.
 Casing height above land surface ? in., weight ? lbs./ft. Wall thickness or gauge No. ?

TYPE OF SCREEN OR PERFORATION MATERIAL:
 1 Steel 3 Stainless steel 5 Fiberglass 7 PVC 10 Asbestos-cement
 2 Brass 4 Galvanized steel 6 Concrete tile 8 RMP (SR) 11 Other (specify).....
 9 ABS 12 None used (open hole)

SCREEN OR PERFORATION OPENINGS ARE:
 1 Continuous slot 3 Mill slot 5 Gauzed wrapped 8 Saw cut 11 None (open hole)
 2 Louvered shutter 4 Key punched 6 Wire wrapped 9 Drilled holes
 7 Torch cut 10 Other (specify).....

SCREEN-PERFORATED INTERVALS: From ? ft. to ? ft., From ? ft. to ? ft., From ? ft. to ? ft.
 GRAVEL PACK INTERVALS: From ? ft. to ? ft., From ? ft. to ? ft., From ? ft. to ? ft.

6 GROUT MATERIAL: 1 Neat cement 2 Cement grout 3 Bentonite 4 Other.....
 Grout intervals: From ? ft. to ? ft., From ? ft. to ? ft., From ? ft. to ? ft.

What is the nearest source of possible contamination:
 1 Septic tank 4 Lateral lines 7 Pit privy 10 Livestock pens 14 Abandoned water well
 2 Sewer lines 5 Cess pool 8 Sewage lagoon 11 Fuel storage 15 Oil well/Gas well
 3 Watertight sewer lines 6 Seepage pit 9 Feedyard 12 Fertilizer storage 16 Other (specify below)
 13 Insecticide storage

Direction from well? How many feet?

FROM	TO	LITHOLOGIC LOG	FROM	TO	PLUGGING INTERVALS
		Plugged Well			
		1. Galvanized casing rusted out.			
		2. Well in 5 ft deep pit			
		3. Plugged with Ready Mix Cement from bottom of well, up to bottom of pit			
		4. Sides caved in and covered			

7 CONTRACTOR'S OR LANDOWNER'S CERTIFICATION: This water well was (1) constructed, (2) reconstructed, or (3) plugged under my jurisdiction and was completed on (mo/day/year) Aug 2 01 and this record is true to the best of my knowledge and belief. Kansas Water Well Contractor's License No. 218 This Water Well Record was completed on (mo/day/yr) Aug 4-01 under the business name of Zinn Water Well Drlg. by (signature) Joseph A. Zinn

OFFICE USE ONLY
T
R
EW
SEC.
1/4
1/4
1/4