


1 LOCATION OF WATER WELL: Fraction SW¹/₄ SW¹/₄ SW¹/₄ Section Number 8 Township Number T 17S Range Number R 4E
 County: Marion

Distance and direction from nearest town or city street address of well if located within city?
3 west 1 North of Lost Springs

2 WATER WELL OWNER: Ronnie Hanchu
 RR#, St. Address, Box #: Rt 1 Ramona KS 67475 Board of Agriculture, Division of Water Resources
 City, State, ZIP Code: Rt 1 Ramona KS 67475 Application Number:

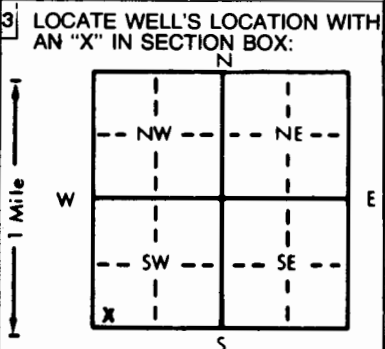

4 DEPTH OF COMPLETED WELL: 4.5 ft. ELEVATION:
 Depth(s) Groundwater Encountered 1. 3.7 ft. 2. ft. 3. ft.
 WELL'S STATIC WATER LEVEL 2.75 ft. below land surface measured on mo/day/yr NOV. 23 88
 Pump test data: Well water was 20 ft. after 2 hours pumping 220 gpm
 Est. Yield 220+ gpm: Well water was ft. after hours pumping gpm
 Bore Hole Diameter: 8 in. to 4.5 ft., and in. to ft.
 WELL WATER TO BE USED AS:
 1 Domestic 3 Feedlot 6 Oil field water supply 9 Dewatering 12 Other (Specify below)
 2 Irrigation 4 Industrial 7 Lawn and garden only 10 Monitoring well
 Was a chemical/bacteriological sample submitted to Department? Yes.....No X.....; If yes, mo/day/yr sample was submitted
 Water Well Disinfected? Yes No

5 TYPE OF BLANK CASING USED:
 1 Steel 3 RMP (SR) 5 Wrought iron 8 Concrete tile CASING JOINTS: Glued X Clamped
 2 PVC 4 ABS 6 Asbestos-Cement 9 Other (specify below) Welded
 7 Fiberglass Threaded
 Blank casing diameter 5 in. to 30 ft., Dia. in. to ft., Dia. in. to ft.
 Casing height above land surface 16 in., weight lbs./ft. Wall thickness or gauge No. SDR 26
 TYPE OF SCREEN OR PERFORATION MATERIAL:
 1 Steel 3 Stainless steel 5 Fiberglass 7 PVC 10 Asbestos-cement
 2 Brass 4 Galvanized steel 6 Concrete tile 8 RMP (SR) 11 Other (specify)
 9 ABS 12 None used (open hole)
 SCREEN OR PERFORATION OPENINGS ARE:
 1 Continuous slot 3 Mill slot 5 Gauzed wrapped 8 Saw cut 11 None (open hole)
 2 Louvered shutter 4 Key punched 6 Wire wrapped 9 Drilled holes
 7 Torch cut 10 Other (specify)
 SCREEN-PERFORATED INTERVALS: From 30 ft. to 45 ft., From ft. to ft.
 From ft. to ft., From ft. to ft.
 GRAVEL PACK INTERVALS: From NONE ft. to ft., From ft. to ft.
 From ft. to ft., From ft. to ft.

6 GROUT MATERIAL: 1 Neat cement 2 Cement grout 3 Bentonite 4 Other
 Grout Intervals: From 3 ft. to 23 ft., From ft. to ft., From ft. to ft.
 What is the nearest source of possible contamination:
 1 Septic tank 4 Lateral lines 7 Pit privy 10 Livestock pens 14 Abandoned water well
 2 Sewer lines 5 Cess pool 8 Sewage lagoon 11 Fuel storage 15 Oil well/Gas well
 3 Watertight sewer lines 6 Seepage pit 9 Feedyard 12 Fertilizer storage 16 Other (specify below)
 13 Insecticide storage
 Direction from well? EAST How many feet? 80

FROM	TO	LITHOLOGIC LOG	FROM	TO	PLUGGING INTERVALS
0	2	Top Soil			
2	5	LIME & Shale Lite			
5	9	Shale Yel			
9	13	LIME Yel			
13	14	LIME Platey Yel			
14	18	Shale Gray			
18	19	LIME Yel			
19	20	Shale Gray			
20	21	LIME lite			
21	31	Shale lite Gray			
31	36	LIME Gray			
36	37	Red Rock			
37	39	LIME Lost Circ.			
39	40	Shale			
40	45	Frac LIME			

7 CONTRACTOR'S OR LANDOWNER'S CERTIFICATION: This water well was (1) constructed, (2) reconstructed, or (3) plugged under my jurisdiction and was completed on (mo/day/year) Nov. 23 88 and this record is true to the best of my knowledge and belief. Kansas
 Water Well Contractor's License No. 218 This Water Well Record was completed on (mo/day/yr) Dec. 2 88
 under the business name of Zinn Water Well Drlg by (signature) Joseph A. Zinn

INSTRUCTIONS: Use typewriter or ball point pen. PLEASE PRESS FIRMLY and PRINT clearly. Please fill in blanks, underline or circle the correct answers. Send top three copies to Kansas Department of Health and Environment, Bureau of Water Protection, Topeka, Kansas 66620-7320. Telephone: 913-296-5514. Send one to WATER WELL OWNER and retain one for your records.