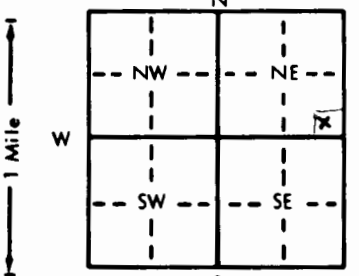


1 LOCATION OF WATER WELL: Fraction SE 1/4 SE 1/4 NE 1/4 Section Number 14 Township Number T 17S Range Number R 4E
 County: Marion

Distance and direction from nearest town or city street address of well if located within city?
1 mile East - 1/2 mile North of Center of Last Springs

2 WATER WELL OWNER: Steve Schild
 RR#, St. Address, Box #: Rt 1 Board of Agriculture, Division of Water Resources
 City, State, ZIP Code: Herington Kansas 67449 Application Number:

3 LOCATE WELL'S LOCATION WITH AN "X" IN SECTION BOX:

 4 DEPTH OF COMPLETED WELL: 125 ft. ELEVATION:
 Depth(s) Groundwater Encountered 1. 114 ft. 2. ft. 3. ft.
 WELL'S STATIC WATER LEVEL 77 ft. below land surface measured on mo/day/yr May 16 89
 Pump test data: Well water was ft. after hours pumping gpm
 Est. Yield 25 gpm: Well water was ft. after hours pumping gpm
 Bore Hole Diameter: 8 in. to 125 ft., and in. to ft.
 WELL WATER TO BE USED AS:
 1 Domestic 1 3 Feedlot 6 Oil field water supply 9 Dewatering 12 Other (Specify below)
 2 Irrigation 4 Industrial 7 Lawn and garden only 10 Monitoring well
 Was a chemical/bacteriological sample submitted to Department? Yes.....No X.....; If yes, mo/day/yr sample was submitted
 Water Well Disinfected? Yes No

5 TYPE OF BLANK CASING USED:
 1 Steel 3 RMP (SR) 5 Wrought iron 8 Concrete tile CASING JOINTS: Glued X Clamped
2 PVC 4 ABS 6 Asbestos-Cement 9 Other (specify below) Welded
 7 Fiberglass Threaded
 Blank casing diameter 5 in. to 90 ft., Dia. in. to ft., Dia. in. to ft.
 Casing height above land surface 16 in., weight lbs./ft. Wall thickness or gauge No. SDR 20
 TYPE OF SCREEN OR PERFORATION MATERIAL:
 1 Steel 3 Stainless steel 5 Fiberglass 7 PVC 10 Asbestos-cement
 2 Brass 4 Galvanized steel 6 Concrete tile 8 RMP (SR) 11 Other (specify)
 9 ABS 12 None used (open hole)
 SCREEN OR PERFORATION OPENINGS ARE:
 1 Continuous slot 3 Mill slot 5 Gauzed wrapped 8 Saw cut 11 None (open hole)
 2 Louvered shutter 4 Key punched 6 Wire wrapped 9 Drilled holes
 7 Torch cut 10 Other (specify)
 SCREEN-PERFORATED INTERVALS: From 90 ft. to 125 ft., From ft. to ft.
 From ft. to ft., From ft. to ft.
 GRAVEL PACK INTERVALS: From NONE ft. to ft., From ft. to ft.
 From ft. to ft., From ft. to ft.

6 GROUT MATERIAL: 1 Neat cement 2 Cement grout 3 Bentonite 4 Other
 Grout Intervals: From 3 ft. to 30 ft., From ft. to ft., From ft. to ft.
 What is the nearest source of possible contamination:
 1 Septic tank 4 Lateral lines 7 Pit privy 10 Livestock pens 14 Abandoned water well
 2 Sewer lines 5 Cess pool 8 Sewage lagoon 11 Fuel storage 15 Oil well/Gas well
 3 Watertight sewer lines 6 Seepage pit 9 Feedyard 12 Fertilizer storage 16 Other (specify below)
 13 Insecticide storage 102 14 65
 Direction from well? 10 North 14 North West
 How many feet? 600 65

FROM	TO	LITHOLOGIC LOG	FROM	TO	PLUGGING INTERVALS
0	1	Top Soil	42	46	LIME TAN
1	5	Clay Brn	46	48	Shale Gray
5	9	Clay Yel	48	60	LIME DK Gray
9	10	LIME Rusty - (SANDSTONE?)	60	67	Shale Gray
10	14	Shale Lite	67	82	LIME Gray
14	16	LIME TAN	82	91	Red Rock
16	16.5	Shale - Yellow	91	102	LIME Gray / Flinty
16.5	17	LIME Lite	102	104	Shale Gray
17	20	Shale Gray & Olive	104	114	LIME Gras
20	21	LIME Lite	114	116	Frac LIME crevice
21	31	Shale Gray	116	125	LIME Solid gray
31	31.5	LIME Lite			
31.5	34	Shale Blue Green			
34	39	Red Rock			
39	42	Shale Gray			

7 CONTRACTOR'S OR LANDOWNER'S CERTIFICATION: This water well was 1 constructed, (2) reconstructed, or (3) plugged under my jurisdiction and was completed on (mo/day/year) May 16 89 and this record is true to the best of my knowledge and belief. Kansas
 Water Well Contractor's License No. 218 This Water Well Record was completed on (mo/day/yr) May 18 89
 under the business name of ZINN Water Well Drlg by (signature) Joseph A. Zinn

INSTRUCTIONS: Use typewriter or ball point pen. PLEASE PRESS FIRMLY and PRINT clearly. Please fill in blanks, underline or circle the correct answers. Send top three copies to Kansas Department of Health and Environment, Bureau of Water Protection, Topeka, Kansas 66620-7320. Telephone: 913-296-5514. Send one to WATER WELL OWNER and retain one for your records.