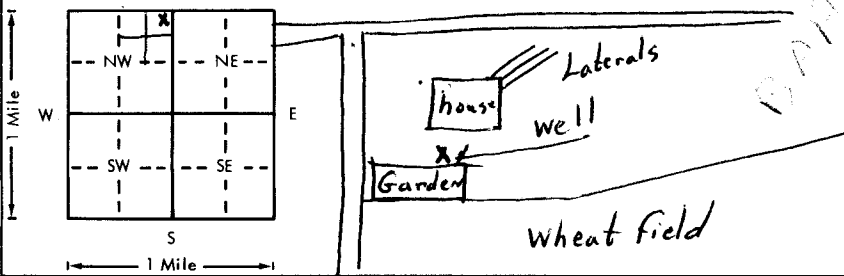


USE TYPEWRITER OR BALL  
POINT PEN-PRESS FIRMLY,  
PRINT CLEARLY.

WATER WELL RECORD  
KSA 82a-1201-1215

Kansas Department of Health and  
Environment-Division of Environment  
(Water well Contractors)  
Topeka, Kansas 66620

1. Location of well:		County <u>Morris</u>	Fraction <u>NE 1/4 NE 1/4 NW 1/4</u>	Section number <u>23</u>	Township number T <u>17</u> S R <u>5</u> <u>EW</u>	Range number
2. Distance and direction from nearest town or city:		<u>IN Burdick</u>		3. Owner of well: <u>Robert Naslund</u> R.R. or street: City, state, zip code: <u>Burdick, Kansas</u>		
Street address of well location if in city: <u>No Street Address</u>						
4. Locate with "X" in section below:		Sketch map:		6. Bore hole dia. <u>6 1/4</u> in. Completion date <u>4-28-77</u> Well depth <u>100</u> ft.		
				7. <input checked="" type="checkbox"/> Cable tool <input type="checkbox"/> Rotary <input type="checkbox"/> Driven <input type="checkbox"/> Dug <input type="checkbox"/> Hollow rod <input type="checkbox"/> Jetted <input type="checkbox"/> Bored <input type="checkbox"/> Reverse rotary		
5. Type and color of material		From	To	8. Use: <input checked="" type="checkbox"/> Domestic <input type="checkbox"/> Public supply <input type="checkbox"/> Industry <input type="checkbox"/> Irrigation <input type="checkbox"/> Air conditioning <input type="checkbox"/> Stock <input type="checkbox"/> Lawn <input type="checkbox"/> Oil field water <input type="checkbox"/> Other		
<u>Topsoil - Blk</u>		<u>0</u>	<u>6</u>	9. Casing: Material <u>PLS</u> Height: <u>Above</u> or below Threaded <input type="checkbox"/> Welded <u>glw</u> Surface <u>14</u> in. RMP <input checked="" type="checkbox"/> PVC <input type="checkbox"/> Weight <u>      </u> lbs./ft. Dia. <u>5</u> in. to <u>90</u> ft. depth Wall Thickness: inches or Dia. <u>      </u> in. to <u>      </u> ft. depth gage No. <u>200</u>		
<u>Broken Lime &amp; Yellow Shale</u>		<u>6</u>	<u>19</u>	10. Screen: Manufacturer's name <u>Sunflower</u> Type <u>RMP</u> Dia. <u>5"</u> Slot/gauze <u>Y8</u> Length <u>10'</u> Set between <u>90</u> ft. and <u>100</u> ft. <u>      </u> ft. and <u>      </u> ft. Gravel pack? <u>Yes</u> Size range of material <u>Y8 - Y2</u>		
<u>Shale - Yellow</u>		<u>19</u>	<u>42</u>	11. Static water level: <u>60</u> ft. below land surface Date <u>4-28-77</u> mo./day/yr.		
<u>Shale - Lite Blue Green</u>		<u>42</u>	<u>51</u>	12. Pumping level below land surfaces: <u>      </u> ft. after <u>      </u> hrs. pumping <u>      </u> g.p.m. <u>      </u> ft. after <u>      </u> hrs. pumping <u>      </u> g.p.m. Estimated maximum yield <u>20</u> g.p.m.		
<u>Red Rock</u>		<u>51</u>	<u>67</u>	13. Water sample submitted: <u>      </u> mo./day/yr. <u>      </u> Yes <input checked="" type="checkbox"/> No <u>      </u> Date <u>      </u>		
<u>Shale - Gray</u>		<u>67</u>	<u>72</u>	14. Well head completion: <input checked="" type="checkbox"/> Pitless adapter <u>14</u> inches above grade		
<u>Lime - Gray</u>		<u>72</u>	<u>77</u>	15. Well grouted? <u>Yes</u> With: <u>      </u> Neat cement <u>      </u> Bentonite <input checked="" type="checkbox"/> Concrete Depth: From <u>3</u> ft. to <u>13</u> ft.		
<u>Shale - Gray</u>		<u>77</u>	<u>79</u>	16. Nearest source of possible contamination: <u>Septic</u> fr. <u>60</u> Direction <u>NE</u> Type <u>Septic</u> Well disinfected upon completion? <input checked="" type="checkbox"/> Yes <input type="checkbox"/> No		
<u>Lime - Gray</u>		<u>79</u>	<u>80</u>	17. Pump: <u>      </u> Not installed Manufacturer's name <u>Gould</u> Model number <u>7EH</u> HP <u>1/2</u> Volts <u>230</u> Length of drop pipe <u>96</u> ft. capacity <u>12</u> g.p.m. Type: <input checked="" type="checkbox"/> Submersible <input type="checkbox"/> Turbine <input type="checkbox"/> Jet <input type="checkbox"/> Reciprocating <input type="checkbox"/> Centrifugal <input type="checkbox"/> Other		
<u>Shale - Blue</u>		<u>80</u>	<u>96</u>			
<u>Shale - Blue</u>		<u>96</u>	<u>100</u>			
(Use a second sheet if needed)						
18. Elevation:	19. Remarks:		20. Water well contractor's certification: This well was drilled under my jurisdiction and this report is true to the best of my knowledge and belief. <u>Zinn Water Well Drilling 218</u> Business name <u>Lost Springs, Kan</u> License No. <u>      </u> Address <u>      </u> Signed <u>Joseph D. Zinn</u> Date <u>5-28-77</u> Authorized representative			
Topography: <input type="checkbox"/> Hill <input type="checkbox"/> Slope <input checked="" type="checkbox"/> Upland <input type="checkbox"/> Valley						

Forward the white, blue and pink copies to the Department of Health and Environment

Form WWC-5