

1 LOCATION OF WATER WELL:	Fraction	Section Number	Township Number	Range Number
County: <u>Morris</u>	<u>NW 1/4 SW 1/4 NE 1/4</u>	<u>34</u>	<u>T 17 S</u>	<u>R 8 E</u>

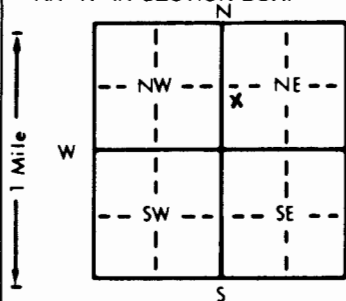
Distance and direction from nearest town or city street address of well if located within city?

8 1/2 mile South & 3/4 East of Council Grove

2 WATER WELL OWNER:	Board of Agriculture, Division of Water Resources
RR#, St. Address, Box #:	Application Number:
City, State, ZIP Code:	

Mashed O RanchRt 1Council Grove, Ks 66846

3 LOCATE WELL'S LOCATION WITH AN "X" IN SECTION BOX:	4 DEPTH OF COMPLETED WELL:	ELEVATION:
--	----------------------------	------------

Depth(s) Groundwater Encountered 1. ? ft. 2. 70 ft. 3. 70 ft.WELL'S STATIC WATER LEVEL 52 ft. below land surface measured on mo/day/yr Apr 26 91Pump test data: Well water was 14 gpm. Well water was 8 ft. after 14 hours pumping 14 gpmEst. Yield 14 gpm. Well water was 8 ft. after 14 hours pumping 14 gpmBore Hole Diameter 8 in. to 8 ft., and 8 in. to 8 ft.

WELL WATER TO BE USED AS:

<input checked="" type="radio"/> 1 Domestic	<input type="radio"/> 3 Feedlot	<input type="radio"/> 6 Oil field water supply	<input type="radio"/> 9 Dewatering	<input type="radio"/> 12 Other (Specify below)
<input type="radio"/> 2 Irrigation	<input type="radio"/> 4 Industrial	<input type="radio"/> 7 Lawn and garden only	<input type="radio"/> 10 Monitoring well	

Was a chemical/bacteriological sample submitted to Department? Yes X No X If yes, mo/day/yr sample was submittedWater Well Disinfected? Yes No

5 TYPE OF BLANK CASING USED:	5 Wrought iron	8 Concrete tile	CASING JOINTS: Glued <u>X</u> Clamped
------------------------------	----------------	-----------------	---------------------------------------

<input type="radio"/> 1 Steel	<input type="radio"/> 3 RMP (SR)	<input type="radio"/> 6 Asbestos-Cement	<input type="radio"/> 9 Other (specify below)	<input type="radio"/> Welded
-------------------------------	----------------------------------	---	---	------------------------------

<input checked="" type="radio"/> 2 PVC	<input type="radio"/> 4 ABS	<input type="radio"/> 7 Fiberglass		<input type="radio"/> Threaded
--	-----------------------------	------------------------------------	--	--------------------------------

Blank casing diameter 5 in. to 5 ft., Dia. 5 in. to 5 ft., Dia. 5 in. to 5 ft.Casing height above land surface 12 in., weight 12 lbs./ft. Wall thickness or gauge No. SPR-26

TYPE OF SCREEN OR PERFORATION MATERIAL:	<input checked="" type="radio"/> 1 PVC	<input type="radio"/> 10 Asbestos-cement
---	--	--

<input type="radio"/> 1 Steel	<input type="radio"/> 3 Stainless steel	<input type="radio"/> 5 Fiberglass	<input type="radio"/> 8 RMP (SR)	<input type="radio"/> 11 Other (specify)
-------------------------------	---	------------------------------------	----------------------------------	--

<input type="radio"/> 2 Brass	<input type="radio"/> 4 Galvanized steel	<input type="radio"/> 6 Concrete tile	<input type="radio"/> 9 ABS	<input type="radio"/> 12 None used (open hole)
-------------------------------	--	---------------------------------------	-----------------------------	--

SCREEN OR PERFORATION OPENINGS ARE:	<input type="radio"/> 5 Gauzed wrapped	<input checked="" type="radio"/> 8 Saw cut	<input type="radio"/> 11 None (open hole)
-------------------------------------	--	--	---

<input type="radio"/> 1 Continuous slot	<input type="radio"/> 3 Mill slot	<input type="radio"/> 6 Wire wrapped	<input type="radio"/> 9 Drilled holes
---	-----------------------------------	--------------------------------------	---------------------------------------

<input type="radio"/> 2 Louvered shutter	<input type="radio"/> 4 Key punched	<input type="radio"/> 7 Torch cut	<input type="radio"/> 10 Other (specify)
--	-------------------------------------	-----------------------------------	--

SCREEN-PERFORATED INTERVALS:	From <u>52</u> ft. to <u>70</u> ft.	
------------------------------	-------------------------------------	-------------------------------------	-------------------------------------	-------------------------------------

GRAVEL PACK INTERVALS: From NONE ft. to NONE ft.

6 GROUT MATERIAL:	<input checked="" type="radio"/> 1 Neat cement	<input type="radio"/> 2 Cement grout	<input type="radio"/> 3 Bentonite	<input type="radio"/> 4 Other
-------------------	--	--------------------------------------	-----------------------------------	-------------------------------

Grout Intervals: From 3 ft. to 26 ft.

What is the nearest source of possible contamination:

<input type="radio"/> 1 Septic tank	<input type="radio"/> 4 Lateral lines	<input type="radio"/> 7 Pit privy	<input type="radio"/> 10 Livestock pens	<input type="radio"/> 14 Abandoned water well
-------------------------------------	---------------------------------------	-----------------------------------	---	---

<input type="radio"/> 2 Sewer lines	<input type="radio"/> 5 Cess pool	<input type="radio"/> 8 Sewage lagoon	<input type="radio"/> 11 Fuel storage	<input type="radio"/> 15 Oil well/Gas well
-------------------------------------	-----------------------------------	---------------------------------------	---------------------------------------	--

<input type="radio"/> 3 Watertight sewer lines	<input type="radio"/> 6 Seepage pit	<input type="radio"/> 9 Feedyard	<input type="radio"/> 12 Fertilizer storage	<input type="radio"/> 16 Other (specify below)
--	-------------------------------------	----------------------------------	---	--

Direction from well? within PastureHow many feet? IN Pasture

FROM	TO	LITHOLOGIC LOG	FROM	TO	PLUGGING INTERVALS
------	----	----------------	------	----	--------------------

This well was re constructed
Formation unknown

7 CONTRACTOR'S OR LANDOWNER'S CERTIFICATION:	This water well was (1) constructed, (2) reconstructed, or (3) plugged under my jurisdiction and was completed on (mo/day/year) <u>Apr 26 91</u>	and this record is true to the best of my knowledge and belief. Kansas
--	--	--

Water Well Contractor's License No. May 13 91under the business name of Zinn Water Well Dng by (signature) Joseph A. Zinn

INSTRUCTIONS: Use typewriter or ball point pen. PLEASE PRESS FIRMLY and PRINT clearly. Please fill in blanks, underline or circle the correct answer. Send top three copies to Kansas Department of Health and Environment, Bureau of Water, Topeka, Kansas 66620-7320. Telephone: 913-296-5545. Send one to WATER WELL OWNER and retain one for your records.