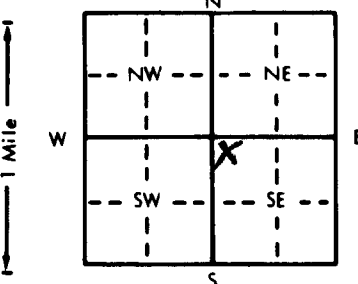


1 LOCATION OF WATER WELL:		Fraction	Section Number	Township Number	Range Number
County: MORRIS		NW 1/4 NW 1/4 SE 1/4	33	T 17 S	R 9 E
Distance and direction from nearest town or city street address of well if located within city? LAKE KAHOLA, LOT 22					
2 WATER WELL OWNER: ERIC JOHNSON FOR STEVE SAUDER					
RR#, St. Address, Box #: 1816 ANTLER RIDGE					
City, State, ZIP Code: EMPORIA, KS 66801					
Board of Agriculture, Division of Water Resources					
Application Number:					
3 LOCATE WELL'S LOCATION WITH AN "X" IN SECTION BOX:		4 DEPTH OF COMPLETED WELL: 125 ft. ELEVATION:			
		Depth(s) Groundwater Encountered 1. 72 ft. 2. ft. 3. ft.			
		WELL'S STATIC WATER LEVEL 15 ft. below land surface measured on mo/day/yr 12/2/99			
		Pump test data: Well water was ft. after hours pumping gpm			
		Est. Yield 2.5 gpm: Well water was ft. after hours pumping gpm			
		Bore Hole Diameter 8.75 in. to 12.5 ft., and in. to ft.			
		WELL WATER TO BE USED AS:			
		1 Domestic 3 Feedlot 6 Oil field water supply 9 Dewatering 12 Other (Specify below)			
		2 Irrigation 4 Industrial 7 Lawn and garden only 10 Monitoring well			
		Was a chemical/bacteriological sample submitted to Department? Yes No; If yes, mo/day/yr sample was submitted			
		Water Well Disinfected? Yes No			
5 TYPE OF BLANK CASING USED:					
1 Steel 3 RMP (SR) 5 Wrought iron 8 Concrete tile CASING JOINTS: Glued X Clamped					
2 PVC 4 ABS 6 Asbestos-Cement 9 Other (specify below) Welded					
7 Fiberglass Threaded					
Blank casing diameter 5 in. to 105 ft., Dia in. to ft., Dia in. to ft.					
Casing height above land surface 24 in., weight lbs./ft. Wall thickness or gauge No. 3DR 26					
TYPE OF SCREEN OR PERFORATION MATERIAL:					
1 Steel 3 Stainless steel 5 Fiberglass 8 RMP (SR) 10 Asbestos-cement					
2 Brass 4 Galvanized steel 6 Concrete tile 9 ABS 11 Other (specify)					
12 None used (open hole)					
SCREEN OR PERFORATION OPENINGS ARE:					
1 Continuous slot 3 Mill slot 5 Gauzed wrapped 8 Saw cut 11 None (open hole)					
2 Louvered shutter 4 Key punched 6 Wire wrapped 9 Drilled holes					
7 Torch cut 10 Other (specify)					
SCREEN-PERFORATED INTERVALS: From 105 ft. to 125 ft., From ft. to ft.					
From ft. to ft., From ft. to ft.					
GRAVEL PACK INTERVALS: From 125 ft. to 25 ft., From ft. to ft.					
From ft. to ft., From ft. to ft.					
6 GROUT MATERIAL: 1 Neat cement 2 Cement grout 3 Bentonite 4 Other					
Grout intervals: From 25 ft. to 3 ft., From ft. to ft., From ft. to ft.					
What is the nearest source of possible contamination:					
1 Septic tank 4 Lateral lines 7 Pit privy 10 Livestock pens 14 Abandoned water well					
2 Sewer lines 5 Cess pool 8 Sewage lagoon 11 Fuel storage 15 Oil well/Gas well					
3 Watertight sewer lines 6 Seepage pit 9 Feedyard 12 Fertilizer storage 16 Other (specify below)					
13 Insecticide storage 17 HOUSE					
Direction from well? East					
How many feet? ~ 50 feet					
FROM TO LITHOLOGIC LOG FROM TO PLUGGING INTERVALS					
0 4 FILL 113 118 LIMESTONE, WHITE					
4 12 LIMESTONE, TAN 118 123 SHALE, TAN					
12 23 SHALE, GREENISH TAN 123 125 LIMESTONE					
23 27 LIMESTONE, TAN 125 TOTAL DEPTH					
27 37 SHALE, GRAY					
37 40 LIMESTONE, GRAY					
40 50 SHALE, GRAY					
50 51 LIMESTONE, GRAY					
51 60 SHALE, LIGHT GRAY					
60 63 LIMESTONE, GRAY					
63 66 SHALE, GRAY					
66 72 LIMESTONE, TAN					
72 80 SHALE, GRAY					
80 101 LIMESTONE, GRAY					
101 113 SHALE, GRAY					
7 CONTRACTOR'S OR LANDOWNER'S CERTIFICATION: This water well was (1) constructed, (2) reconstructed, or (3) plugged under my jurisdiction and was completed on (mo/day/year) 12/2/99 and this record is true to the best of my knowledge and belief. Kansas Water Well Contractor's License No. 585 This Water Well Record was completed on (mo/day/yr) 12/10/99 under the business name of ASSOCIATED ENVIRONMENTAL, INC. by (signature)					