


1	LOCATION OF WATER WELL:	Fraction	Section Number	Township Number	Range Number
County:	Morris	NW ¼ SE ¼ NE ¼	9	T 17 S	R 9 E

Distance and direction from nearest town or city street address of well if located within city?  
4 miles south of Council Grove South one mile on 400 Rd.

2 WATER WELL OWNER: Frank & Judy Goodrich  
 RR#, St. Address, Box # : 2026 S. 400 Rd.  
 City, State, ZIP Code : Council Grove, KS, 66846

Board of Agriculture, Division of Water Resources  
 Application Number:

3 LOCATE WELL'S LOCATION WITH AN "X" IN SECTION BOX: 4 DEPTH OF COMPLETED WELL: 60 ft. ELEVATION: 1000

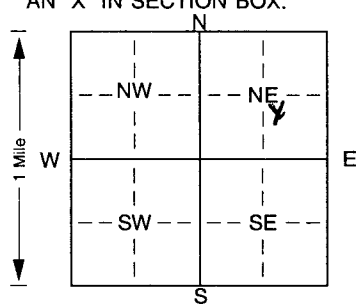

Depths) Groundwater Encountered 1. 20 ft. 2. 20 ft. 3. 20 ft.

WELL'S STATIC WATER LEVEL 19 ft. below land surface measured on mo/day/yr

Pump test data: Well water was \_\_\_\_\_ ft. after \_\_\_\_\_ hours pumping \_\_\_\_\_ gpm

Est. Yield \_\_\_\_\_ gpm Well water was \_\_\_\_\_ ft. after \_\_\_\_\_ hours pumping \_\_\_\_\_ gpm

Bore Hole Diameter \_\_\_\_\_ in. to 60 ft., and \_\_\_\_\_ in. to \_\_\_\_\_ ft.

WELL WATER TO BE USED AS:

5 Public water supply	8 Air conditioning	11 Injection well
<u>4 Domestic</u>	3 Feedlot	6 Oil field water supply
2 Irrigation	4 Industrial	7 Domestic (lawn & garden)
		10 Monitoring well
		9 Dewatering
		12 Other (Specify below)

Was a chemical/bacteriological sample submitted to Department? Yes. \_\_\_\_\_ No. \_\_\_\_\_ ; If yes, mo/day/yr sample was submitted

Water Well Disinfected? Yes No

5	TYPE OF BLANK CASING USED:	5 Wrought iron	8 Concrete tile	CASING JOINTS: <u>Glued</u> . . . . . Clamped. . . . .
---	----------------------------	----------------	-----------------	--

1 Steel	3 RMP (SR)	6 Asbestos-Cement	9 Other (specify below)	Welded . . . . .
2 PVC	4 ABS	7 Fiberglass	.....	Threaded . . . . .

Blank casing diameter ..... 5 ..... in. to 40 ..... ft. Dia ..... in. to ..... ft. Dia ..... in. to ..... ft.  
Casing height above land surface ..... 2 ..... in., weight 50 ..... lbs./ft. Wall thickness or gauge No. ....

TYPE OF SCREEN OR PERFORATION MATERIAL: PVC 10 Asbestos-cement

1 Steel	3 Stainless steel	5 Fiberglass	8 RMP (SR)	11 Other (specify) . . . . .
2 Brass	4 Galvanized steel	6 Concrete tile	9 ABS	12 None used (open hole)

SCREEN OR PERFORATION OPENINGS ARE:

1 Continuous slot	3 Mill slot	5 Gauzed wrapped	8 Saw cut	11 None (open hole)
2 Louvered shutter	4 Key punched	6 Wire wrapped	9 Drilled holes	
		7 Torch cut	10 Other (specify) . . . . .	ft.

SCREEN-PERFORATED INTERVALS: From 40 ft. to 60 ft., From ft. to ft.  
From ft. to ft., From ft. to ft.  
GRAVEL PACK INTERVALS: From 25 ft. to 60 ft., From ft. to ft.  
From ft. to ft., From ft. to ft.

6 GROUT MATERIAL: 1 Neat cement 2 Cement grout 3 ~~Bentonite~~ 4 Other  
Grout Intervals: From 0 ft. to 25 ft., From . ft. to . ft., From . ft. to . ft., From . ft. to . ft.

What is the nearest source of possible contamination:

1 Septic tank	4 Lateral lines	7 Pit privy	10 Livestock pens	14 Abandoned water well
2 Sewer lines	5 Cess pool	8 Sewage lagoon	11 Fuel storage	15 Oil well/Gas well
3 Watertight sewer lines	6 Seepage pit	9 Feedyard	12 Fertilizer storage	16 Other (specify below)
			13 Insecticide storage	<u>Lagoon</u>

Direction from well? 130°

How many feet? South East

[illegible]

CONTRACTOR'S OR LANDOWNER'S CERTIFICATION: This water well was (1) constructed, (2) reconstructed, or (3) plugged under my jurisdiction and was completed on (mo/day/year) 7/17/2001 and this record is true to the best of my knowledge and belief. Kansas Water Well Contractor's Licence No. 451 This Water Well Record was completed on (mo/day/yr) 8/6/2001 under the business name of Haldeman Well Drilling by (signature) Chris W. Cropp