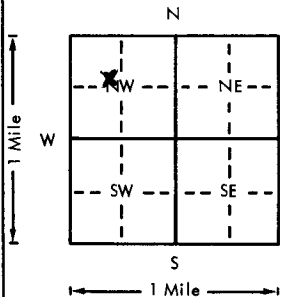
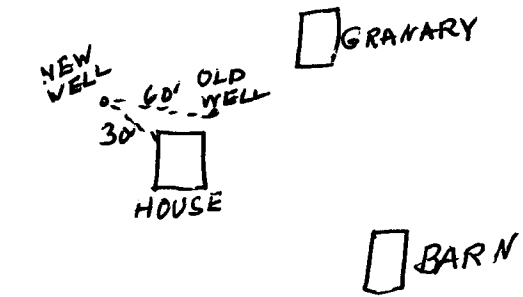


USE TYPEWRITER OR BALL
POINT PEN-PRESS FIRMLY,
PRINT CLEARLY.

WATER WELL RECORD
KSA 82a-1201-1215

Kansas Department of Health and
Environment-Division of Environment
(Water well Contractors)
Topeka, Kansas 66620

1. Location of well:		County Marion	Fraction SE 1/4 NW 1/4 NW 1/4	Section number 11	Township number T 18 S	Range number R 1 E
2. Distance and direction from nearest town or city: Street address of well location 60-3 W. Durham			3. Owner of well: E. E. Oblander R.R. or street: 512 W. Grand City, state, zip code: Hillsboro, Kans. 67063			
4. Locate with "X" in section below: <div style="text-align: center;">  </div>			Sketch map: <div style="text-align: center;">  </div>			
5. Type and color of material			From	To	6. Bore hole dia. 8 in. Completion date 4/12/77 Well depth 60 ft.	
Top soil			0	6	7. <input checked="" type="checkbox"/> Cable tool <input type="checkbox"/> Rotary <input type="checkbox"/> Driven <input type="checkbox"/> Dug <input type="checkbox"/> Hollow rod <input type="checkbox"/> Jetted <input type="checkbox"/> Bored <input type="checkbox"/> Reverse rotary	
Yellow			6	40	8. Use: <input type="checkbox"/> Domestic <input type="checkbox"/> Public supply <input type="checkbox"/> Industry <input type="checkbox"/> Irrigation <input type="checkbox"/> Air conditioning <input checked="" type="checkbox"/> Stock <input type="checkbox"/> Lawn <input type="checkbox"/> Oil field water <input type="checkbox"/> Other	
Blue mud			40	50	9. Casing: Material plst Height: Above surface Threaded <input type="checkbox"/> Welded <input checked="" type="checkbox"/> Surface 18 in. RMP <input checked="" type="checkbox"/> PVC <input type="checkbox"/> Weight <input type="checkbox"/> lbs./ft. Dia. 5 in. to 60 ft. depth Wall thickness: 0.298 in. or Dia. <input type="checkbox"/> in. to <input type="checkbox"/> ft. depth gage No. <input type="checkbox"/>	
Gray			50	60	10. Screen: Manufacturer's name Western Plastics Type RMP Dia. 5" Slot/gauze 3/32 Length 10' Set between 50 ft. and 60 ft. Gravel pack? Yes Size range of material 1/16 to 3/8	
					11. Static water level: <input type="checkbox"/> mo./day/yr. 30 ft. below land surface Date 4/12/77	
					12. Pumping level below land surfaces: ____ ft. after ____ hrs. pumping ____ g.p.m. ____ ft. after ____ hrs. pumping ____ g.p.m. Estimated maximum yield 4 g.p.m.	
					13. Water sample submitted: ____ mo./day/yr. <input type="checkbox"/> Yes <input checked="" type="checkbox"/> No Date ____	
					14. Well head completion: <input type="checkbox"/> Pitless adapter 18 inches above grade	
					15. Well grouted? Yes With: <input checked="" type="checkbox"/> Neat cement <input type="checkbox"/> Bentonite <input type="checkbox"/> Concrete Depth: From 0 ft. to 10 ft.	
					16. Nearest source of possible contamination: ft. 60 Direction east Type old well Well disinfected upon completion? <input checked="" type="checkbox"/> Yes <input type="checkbox"/> No	
					17. Pump: <input checked="" type="checkbox"/> Not installed Manufacturer's name ____ Model number ____ HP ____ Volts ____ Length of drop pipe ____ ft. capacity ____ g.p.m. Type: <input type="checkbox"/> Submersible <input type="checkbox"/> Turbine <input type="checkbox"/> Jet <input type="checkbox"/> Reciprocating <input type="checkbox"/> Centrifugal <input type="checkbox"/> Other	
			(Use a second sheet if needed)			
18. Elevation:		19. Remarks:				
Topography: <input type="checkbox"/> Hill <input type="checkbox"/> Slope <input type="checkbox"/> Upland <input type="checkbox"/> Valley		20. Water well contractor's certification: This well was drilled under my jurisdiction and this report is true to the best of my knowledge and belief. Rader Drilling Co. 194 Business name License No. 67429 Address Carlton, Kansas Signed Burt E. Rader Date 5-22-77 Authorized representative				

Forward the white, blue and pink copies to the Department of Health and Environment

Form WWC-5