


1 LOCATION OF WATER WELL: Fraction NW 1/4 NW 1/4 NW 1/4 Section Number 12 R Township Number T 18 S Range Number R 10 EW
 County: LYON

Distance and direction from nearest town or city street address of well if located within city?
502 WALNUT LOT 1, ÷ THE EAST 1/2 OF LOT 2, BLOCK 105

2 WATER WELL OWNER: MARITA ROBERTSON
 RR#, St. Address, Box #: 502 WALNUT, BOX 145
 City, State, ZIP Code: AMERICUS, KS. 66835
 Board of Agriculture, Division of Water Resources
 Application Number:

3 LOCATE WELL'S LOCATION WITH AN "X" IN SECTION BOX: 4 DEPTH OF COMPLETED WELL: 30 ft. ELEVATION:

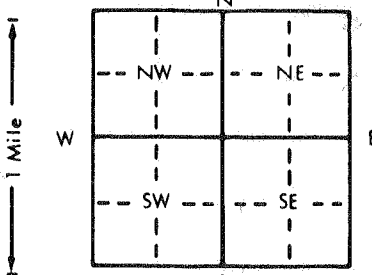

Depth(s) Groundwater Encountered ft. 2. ft. 3. ft.
 WELL'S STATIC WATER LEVEL 15 ft. below land surface measured on mo/day/yr 7-29-95
 Pump test data: Well water was ft. after hours pumping gpm
 Est. Yield gpm: Well water was ft. after hours pumping gpm
 Bore Hole Diameter in. to ft., and in. to ft.
 WELL WATER TO BE USED AS: 5 Public water supply 8 Air conditioning 11 Injection well
 Domestic 3 Feedlot 6 Oil field water supply 9 Dewatering 12 Other (Specify below)
 2 Irrigation 4 Industrial 7 Lawn and garden only 10 Monitoring well
 Was a chemical/bacteriological sample submitted to Department? Yes No If yes, mo/day/yr sample was submitted
 Water Well Disinfected? Yes No

5 TYPE OF BLANK CASING USED: 5 Wrought iron 8 Concrete tile CASING JOINTS: Glued Clamped
 1 Steel 3 RMP (SR) 6 Asbestos-Cement 9 Other (specify below) Welded
 2 PVC 4 ABS 7 Fiberglass LIMESTONE Threaded
 Blank casing diameter 30" in. to ft., Dia in. to ft., Dia in. to ft.
 Casing height above land surface 60" in., weight lbs./ft. Wall thickness or gauge No.

TYPE OF SCREEN OR PERFORATION MATERIAL: 7 PVC 10 Asbestos-cement
 1 Steel 3 Stainless steel 5 Fiberglass 8 RMP (SR) 11 Other (specify) 114
 2 Brass 4 Galvanized steel 6 Concrete tile 9 ABS 12 None used (open hole)
 SCREEN OR PERFORATION OPENINGS ARE: 5 Gauzed wrapped 8 Saw cut 11 None (open hole)
 1 Continuous slot 3 Mill slot 6 Wire wrapped 9 Drilled holes
 2 Louvered shutter 4 Key punched 7 Torch cut 10 Other (specify)

SCREEN-PERFORATED INTERVALS: From 999 ft. to 999 ft., From ft. to ft.
 GRAVEL PACK INTERVALS: From ft. to ft., From ft. to ft.

6 GROUT MATERIAL: 1 Neat cement 2 Cement grout Bentonite 4 Other
 Grout Intervals: From 5.0' ft. to 4.5' ft., From ft. to ft.

What is the nearest source of possible contamination:
 1 Septic tank 4 Lateral lines 7 Pit privy 10 Livestock pens 14 Abandoned water well
 2 Sewer lines 5 Cess pool 8 Sewage lagoon 11 Fuel storage 15 Oil well/Gas well
 3 Watertight sewer lines 6 Seepage pit 9 Feedyard 12 Fertilizer storage 16 Other (specify below)
 13 Insecticide storage

Direction from well? How many feet?

FROM	TO	LITHOLOGIC LOG	FROM	TO	PLUGGING INTERVALS
30'	25'	SAND			
25'	5'	CLAY SOIL : ROCKS			
5'	4.5'	BENTONITE			
4.5'	0	SOIL - FILL MATERIAL			

7 CONTRACTOR'S OR LANDOWNER'S CERTIFICATION: This water well was (1) constructed, (2) reconstructed, or plugged under my jurisdiction and was completed on (mo/day/year) 7-29-95 and this record is true to the best of my knowledge and belief. Kansas Water Well Contractor's License No. This Water Well Record was completed on (mo/day/yr) 7-29-95 under the business name of by (signature) Bob A. Jackson