


1 LOCATION OF WATER WELL: Fraction NW 1/4 NW 1/4 NW 1/4 Section Number 1 Township Number T 18 S Range Number R 10 E/W
 County: Lyon
 Distance and direction from nearest town or city street address of well if located within city?
7 1/2 mi. SW of Emporia

2 WATER WELL OWNER: Harold Higgins
 RR#, St. Address, Box #: R.R. #4
 City, State, ZIP Code: Emporia Kansas 66801
 Board of Agriculture, Division of Water Resource
 Application Number:

3 LOCATE WELL'S LOCATION WITH AN "X" IN SECTION BOX:

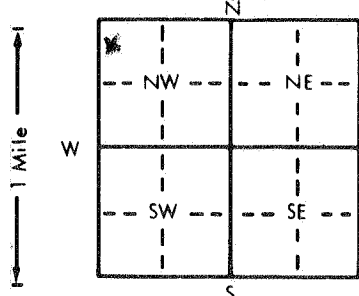

4 DEPTH OF COMPLETED WELL: 75 ft. ELEVATION: slope

 WELL WATER TO BE USED AS: 5 Public water supply 8 Air conditioning 11 Injection well
1 Domestic 3 Feedlot 6 Oil field water supply 9 Dewatering 12 Other (Specify below)
 2 Irrigation 4 Industrial 7 Lawn and garden only 10 Observation well

Was a chemical/bacteriological sample submitted to Department? Yes ✓ No ✓; If yes, mo/day/yr sample was submitted
 Water Well Disinfected? Yes ✓ No ✓

5 TYPE OF BLANK CASING USED: 5 Wrought iron 8 Concrete tile CASING JOINTS: Glued ✓ Clamped ✓
 1 Steel 3 RMP (SR) 6 Asbestos-Cement 9 Other (specify below) Welded ✓
 2 PVC 4 ABS 7 Fiberglass Threaded ✓

 Casing height above land surface 12 in., weight 2.33 lbs./ft. Wall thickness or gauge No. 2.14

TYPE OF SCREEN OR PERFORATION MATERIAL: 7 PVC 10 Asbestos-cement
 1 Steel 3 Stainless steel 5 Fiberglass 8 RMP (SR) 11 Other (specify)
 2 Brass 4 Galvanized steel 6 Concrete tile 9 ABS 12 None used (open hole)

SCREEN OR PERFORATION OPENINGS ARE: 5 Gauzed wrapped 8 Saw cut 11 None (open hole)
 1 Continuous slot 3 Mill slot 6 Wire wrapped 9 Drilled holes
 2 Louvered shutter 4 Key punched 7 Torch cut 10 Other (specify)


6 GROUT MATERIAL: 1 Neat cement 2 Cement grout 3 Bentonite 4 Other

What is the nearest source of possible contamination: 10 Livestock pens 14 Abandoned water well
 1 Septic tank 4 Lateral lines 7 Pit privy 11 Fuel storage 15 Oil well/Gas well
 2 Sewer lines 5 Cess pool 8 Sewage lagoon 12 Fertilizer storage 16 Other (specify below)
 3 Watertight sewer lines 6 Seepage pit 9 Feedyard 13 Insecticide storage

Direction from well? S. How many feet? 50

FROM	TO	LITHOLOGIC LOG	FROM	TO	LITHOLOGIC LOG
0	2	Top Soil	58 1/2	61	shale (gray)
2	3	Tan clay	61	62 1/2	rock
3	8	rock (tan)	62 1/2	75	shale (gray)
8	10	clay			
10	17	rock			
17	20	shale (red)			
20	24	shale (gray)			
24	27	rock			
27	33	shale (gray)			
33	37	rock			
37	39	shale (gray)			
39	45	rock			
45	49	shale (red)			
49	57	shale (gray)			
57	58 1/2	rock			

7 CONTRACTOR'S OR LANDOWNER'S CERTIFICATION: This water well was (1) constructed, (2) reconstructed, or (3) plugged under my jurisdiction and was completed on (mo/day/year) 11-14-84 and this record is true to the best of my knowledge and belief. Kansas Water Well Contractor's License No. 372 This Water Well Record was completed on (mo/day/yr) 12-7-84

under the business name of Lespagnard Water Well Contrs. by (signature) George J. Lespagnard

INSTRUCTIONS: Use typewriter or ball point pen, PLEASE PRESS FIRMLY and PRINT clearly. Please fill in blanks, underline or circle the correct answers. Send top three copies to Kansas Department of Health and Environment, Division of Environment, Environmental Geology Section, Topeka, KS 66620. Send one to WATER WELL OWNER and retain one for your records.