


1 LOCATION OF WATER WELL: Fraction Section Number Township Number Range Number
 County: **LYDN** **SE 1/4 SE 1/4 SW 1/4** **2** **T 18 S** **R 10 EW**

Distance and direction from nearest town or city street address of well if located within city?
W OF HWAY STOP - N SIDE OF ROAD AT CITY PROPERTY LINE - CITY OF AMERICUS

2 WATER WELL OWNER: **TDM GLASS**
 RR#, St. Address, Box #: **BOX 450**
 City, State, ZIP Code: **RR 1 - AMERICUS KS 66835**
 Board of Agriculture, Division of Water Resources
 Application Number:

3 LOCATE WELL'S LOCATION WITH AN "X" IN SECTION BOX:

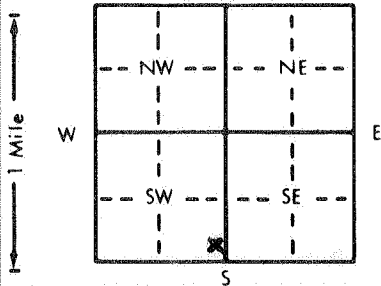

4 DEPTH OF COMPLETED WELL: * **28** ft. ELEVATION: **-**

Depth(s) Groundwater Encountered 1. **UNKNOWN** ft. 2. **-** ft. 3. **-** ft.
 WELL'S STATIC WATER LEVEL **11** ft. below land surface measured on mo/day/yr **01-18-92**
 Pump test data: Well water was **NA** ft. after **-** hours pumping **-** gpm
 Est. Yield **NA** gpm: Well water was **-** ft. after **-** hours pumping **-** gpm
 Bore Hole Diameter * **-** in. to **-** ft., and **-** in. to **-** ft.
 WELL WATER TO BE USED AS:
 5 Public water supply 8 Air conditioning 11 Injection well
 ① Domestic 3 Feedlot 6 Oil field water supply 9 Dewatering 12 Other (Specify below)
 2 Irrigation 4 Industrial 7 Lawn and garden only 10 Monitoring well **PLUGGED**
 Was a chemical/bacteriological sample submitted to Department? Yes **-** No **X**; If yes, mo/day/yr sample was submitted **-**
 Water Well Disinfected? Yes **X** No **-**

5 TYPE OF BLANK CASING USED:
 1 Steel 3 RMP (SR) 5 Wrought iron 8 Concrete tile CASING JOINTS: Glued **UNKNOWN**
 2 **PVC** 4 ABS 6 Asbestos-Cement 9 Other (specify below) Welded **-**
 7 Fiberglass **9 GALV. TIN - RUSTED OUT** Threaded **-**

Blank casing diameter **4** in. to * **28** ft. Dia. **3** in. to **UNKNOWN** ft. Dia. **-** in. to **-** ft.
 Casing height above land surface **- 34** in., weight **UNKNOWN** lbs./ft. Wall thickness or gauge No. **-**


TYPE OF SCREEN OR PERFORATION MATERIAL: **UNKNOWN**
 1 Steel 3 Stainless steel 5 Fiberglass 8 RMP (SR) 10 Asbestos-cement
 2 Brass 4 Galvanized steel 6 Concrete tile 9 ABS 11 Other (specify) **-**
 12 None used (open hole)

SCREEN OR PERFORATION OPENINGS ARE: **UNKNOWN**
 1 Continuous slot 3 Mill slot 5 Gauzed wrapped 8 Saw cut 11 None (open hole)
 2 Louvered shutter 4 Key punched 6 Wire wrapped 9 Drilled holes
 7 Torch cut 10 Other (specify) **-**

SCREEN-PERFORATED INTERVALS: From **UNKNOWN** ft. to **-** ft., From **-** ft. to **-** ft., From **-** ft. to **-** ft.
 GRAVEL PACK INTERVALS: From **UNKNOWN** ft. to **-** ft., From **-** ft. to **-** ft., From **-** ft. to **-** ft.

6 GROUT MATERIAL: * **1 Neat cement** 2 Cement grout * **3 Bentonite** 4 Other **-**
 Grout Intervals: From **GL** ft. to **11** ft., From **-** ft. to **-** ft., From **-** ft. to **-** ft., From **-** ft. to **-** ft.

What is the nearest source of possible contamination:
 1 Septic tank 4 Lateral lines 7 Pit privy 10 Livestock pens 14 Abandoned water well
 2 Sewer lines 5 Cess pool 8 **Sewage lagoon** 11 Fuel storage 15 Oil well/Gas well
 3 Watertight sewer lines 6 Seepage pit 9 Feedyard 12 Fertilizer storage 16 Other (specify below) **-**
 13 Insecticide storage
 Direction from well? **SW** How many feet? **100'**

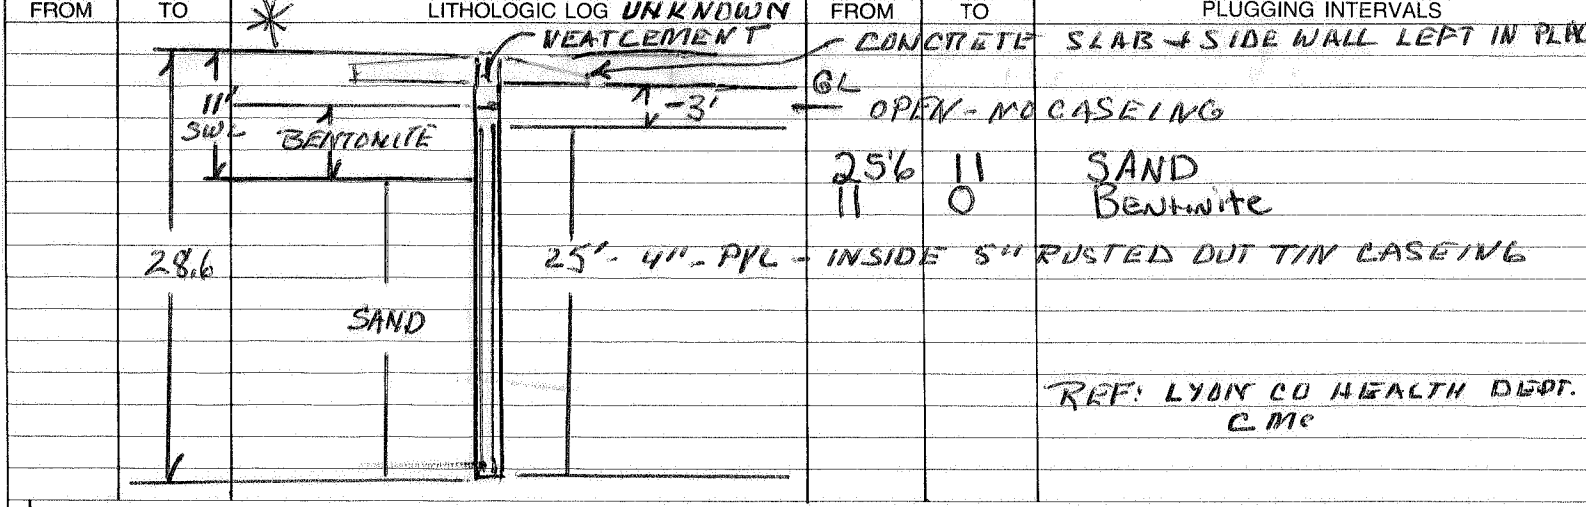

7 CONTRACTOR'S OR LANDOWNER'S CERTIFICATION: This water well was (1) constructed, (2) reconstructed, or (3) **plugged** under my jurisdiction and was completed on (mo/day/year) **1-20-92** and this record is true to the best of my knowledge and belief. Kansas Water Well Contractor's License No. **479** This Water Well Record was completed on (mo/day/yr) **1-20-92** under the business name of **EBBERTS DRILLING** by (signature) **Arnon Ebberts**