


1 LOCATION OF WATER WELL: Fraction SE 1/4 SE 1/4 SW 1/4 Section Number 2 Township Number T 18 S Range Number R 10 EW
 County: LYON

Distance and direction from nearest town or city street address of well if located within city?
W OF 4WAY STOP - N OF ROAD AT CITY PROPERTY LINE - CITY OF AMERICUS

2 WATER WELL OWNER: TOM GLASS
 RR#, St. Address, Box #: BOX 450
 City, State, ZIP Code: RR 1 - AMERICUS KS - 66835
 Board of Agriculture, Division of Water Resources
 Application Number: _____

3 LOCATE WELL'S LOCATION WITH AN "X" IN SECTION BOX:

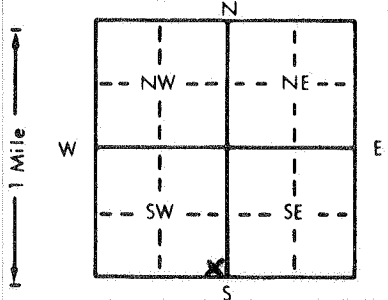

4 DEPTH OF COMPLETED WELL: 32.5 ft. ELEVATION: _____

Depth(s) Groundwater Encountered 1. UNKNOWN ft. 2. _____ ft. 3. _____ ft.
 WELL'S STATIC WATER LEVEL 10.5 ft. below land surface measured on mo/day/yr 01-18-92
 Pump test data: Well water was NA ft. after _____ hours pumping _____ gpm
 Est. Yield _____ gpm Well water was _____ ft. after _____ hours pumping _____ gpm
 Bore Hole Diameter UNKNOWN in. to _____ ft., and _____ in. to _____ ft.
 WELL WATER TO BE USED AS: 5 Public water supply 8 Air conditioning 11 Injection well
 1 Domestic 3 Feedlot 6 Oil field water supply 9 Dewatering 12 Other (Specify below)
 2 Irrigation 4 Industrial 7 Lawn and garden only 10 Monitoring well _____
 Was a chemical/bacteriological sample submitted to Department? Yes _____ No X If yes, mo/day/yr sample was submitted _____
 Water Well Disinfected? Yes X No _____

5 TYPE OF BLANK CASING USED:
 1 Steel 3 RMP (SR) 5 Wrought iron 8 Concrete tile CASING JOINTS: Glued Clamped _____
 2 PVC 4 ABS 6 Asbestos-Cement 9 Other (specify below) Welded UNKNOWN
 7 Fiberglass _____ Threaded _____

Blank casing diameter _____ in. to TD ft., Dia _____ in. to _____ ft., Dia _____ in. to _____ ft.
 Casing height above land surface 20 in., weight SC4 40 lbs./ft. Wall thickness or gauge No. _____

TYPE OF SCREEN OR PERFORATION MATERIAL: *
 1 Steel 3 Stainless steel 5 Fiberglass 8 RMP (SR) 10 Asbestos-cement
 2 Brass 4 Galvanized steel 6 Concrete tile 9 ABS 11 Other (specify) _____
 12 None used (open hole) _____

SCREEN OR PERFORATION OPENINGS ARE: * UNKNOWN
 1 Continuous slot 3 Mill slot 5 Gauzed wrapped 8 Saw cut 11 None (open hole)
 2 Louvered shutter 4 Key punched 6 Wire wrapped 9 Drilled holes
 7 Torch cut 10 Other (specify) _____

SCREEN-PERFORATED INTERVALS: From UNKNOWN ft. to _____ ft., From _____ ft. to _____ ft.
 From _____ ft. to _____ ft., From _____ ft. to _____ ft.
 GRAVEL PACK INTERVALS: From UNKNOWN ft. to _____ ft., From _____ ft. to _____ ft.
 From _____ ft. to _____ ft., From _____ ft. to _____ ft.

6 GROUT MATERIAL: * 1 Neat cement 2 Cement grout * 3 Bentonite * 4 Other CLAY - NOTE SURFACE ONLY
 Grout Intervals: From 1.5 ft. to 3.6 ft., From _____ ft. to _____ ft., From _____ ft. to _____ ft.

What is the nearest source of possible contamination:
 1 Septic tank 4 Lateral lines 7 Pit privy 10 Livestock pens 14 Abandoned water well
 2 Sewer lines 5 Cess pool 8 Sewage lagoon 11 Fuel storage 15 Oil well/Gas well
 3 Watertight sewer lines 6 Seepage pit 9 Feedyard 12 Fertilizer storage 16 Other (specify below) _____
 13 Insecticide storage _____

Direction from well? N How many feet? 100 DOWN SLOPE

FROM	TO	LITHOLOGIC LOG	FROM	TO	PLUGGING INTERVALS
		* <u>NO RECORD!</u>			
		<u>TOP 14" OF CASING WAS RUSTED THROUGH - SURFACE CONTAMINATION -</u>			
					<u>WATER TIGHT SEAL</u>
					<u>HEAT CEMENT GL</u>
					<u>CLAY BACK FILL</u>
					<u>3'</u>
					<u>BENTONITE</u>
					<u>OLD STEEL CASING</u>
		<u>REP: LYON CO HEALTH DEPT!</u>			
		<u>CMC</u>			

7 CONTRACTOR'S OR LANDOWNER'S CERTIFICATION: This water well was (1) constructed, (2) reconstructed, or (3) plugged under my jurisdiction and was completed on (mo/day/year) 1-20-92 and this record is true to the best of my knowledge and belief. Kansas Water Well Contractor's License No. 479. This Water Well Record was completed on (mo/day/yr) 1-20-92 under the business name of EBBERTS DRILLING by (signature) Gregory Ebberts