


1 LOCATION OF WATER WELL:
County: LYON
Fraction: SW 1/4 SW 1/4 SE 1/4
Section Number: 34
Township Number: T 18 S
Range Number: R 11 E

Distance and direction from nearest town or city street address of well if located within city?
EMPORIA KS. 107. HW 135 + 99 - 100 N


2 WATER WELL OWNER: JAMES HARRIS
RR#, St. Address, Box #: RR 11
City, State, ZIP Code: EMPORIA KS 66801
Board of Agriculture, Division of Water Resources
Application Number:

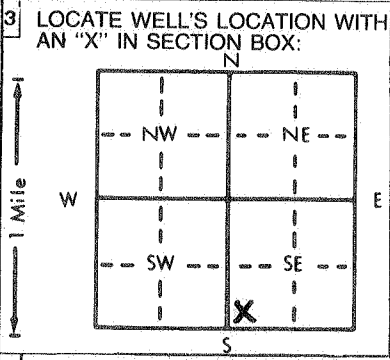

3 LOCATE WELL'S LOCATION WITH AN 'X' IN SECTION BOX:
4 DEPTH OF COMPLETED WELL: NA ft. ELEVATION: NA ft.
Depth(s) Groundwater Encountered: 1 NA ft. 2 NA ft. 3 NA ft.
WELL'S STATIC WATER LEVEL: 13 ft. below land surface measured on mo/day/yr 04-13-89
Pump test data: Well water was NA ft. after NA hours pumping NA gpm
Est. Yield: NA gpm; Well water was NA ft. after NA hours pumping NA gpm
Bore Hole Diameter: UNKNOWN ft., and UNKNOWN in. to UNKNOWN ft.
WELL WATER TO BE USED AS: 5 Public water supply 8 Air conditioning 11 Injection well
1 Domestic 3 Feedlot 6 Oil field water supply 9 Dewatering 12 Other (Specify below)
2 Irrigation 4 Industrial 7 Lawn and garden only 10 Monitoring well
Was a chemical/bacteriological sample submitted to Department? Yes No X; If yes, mo/day/yr sample was submitted: NA
Water Well Disinfected? Yes X No

5 TYPE OF BLANK CASING USED: 1 Steel 3 RMP (SR) 5 Wrought iron 8 Concrete tile CASING JOINTS: Glued X Clamped
2 PVC 4 ABS 6 Asbestos-Cement 9 Other (specify below) Welded UNKNOWN
3 Fiberglass Threaded UNKNOWN
Blank casing diameter: STEEL 6 in. to UNKNOWN ft. Dia. APPROX. 4' BELOW GL. Dia.
Casing height above land surface: 1' PVC in cement 1' BELOW GL. lbs./ft. Wall thickness or gauge No.
TYPE OF SCREEN OR PERFORATION MATERIAL: UNKNOWN
1 Steel 3 Stainless steel 5 Fiberglass 7 PVC 10 Asbestos-cement
2 Brass 4 Galvanized steel 6 Concrete tile 8 RMP (SR) 11 Other (specify)
3 Gauzed wrapped 5 8 Saw cut 11 None (open hole)
6 Wire wrapped 9 Drilled holes
7 Torch cut 10 Other (specify)
SCREEN OR PERFORATION OPENINGS ARE: UNKNOWN
1 Continuous slot 3 Mill slot 4 Key punched
2 Louvered shutter 4 Key punched
SCREEN-PERFORATED INTERVALS: From UNKNOWN ft. to ft. From ft. to ft.
GRAVEL PACK INTERVALS: From UNKNOWN ft. to ft. From ft. to ft.

6 GROUT MATERIAL: 1 Neat cement 2 Cement grout 3 Bentonite 4 Other
Grout Intervals: From ft. to ft. From ft. to ft. From ft. to ft.
What is the nearest source of possible contamination:
1 Septic tank 4 Lateral lines 7 Pit privy 10 Livestock pens 14 Abandoned water well
2 Sewer lines 5 Cess pool 8 Sewage lagoon 11 Fuel storage 15 Oil well/Gas well
3 Watertight sewer lines 6 Seepage pit 9 Feedyard 12 Fertilizer storage 16 Other (specify below)
13 Insecticide storage
Direction from well? How many feet?

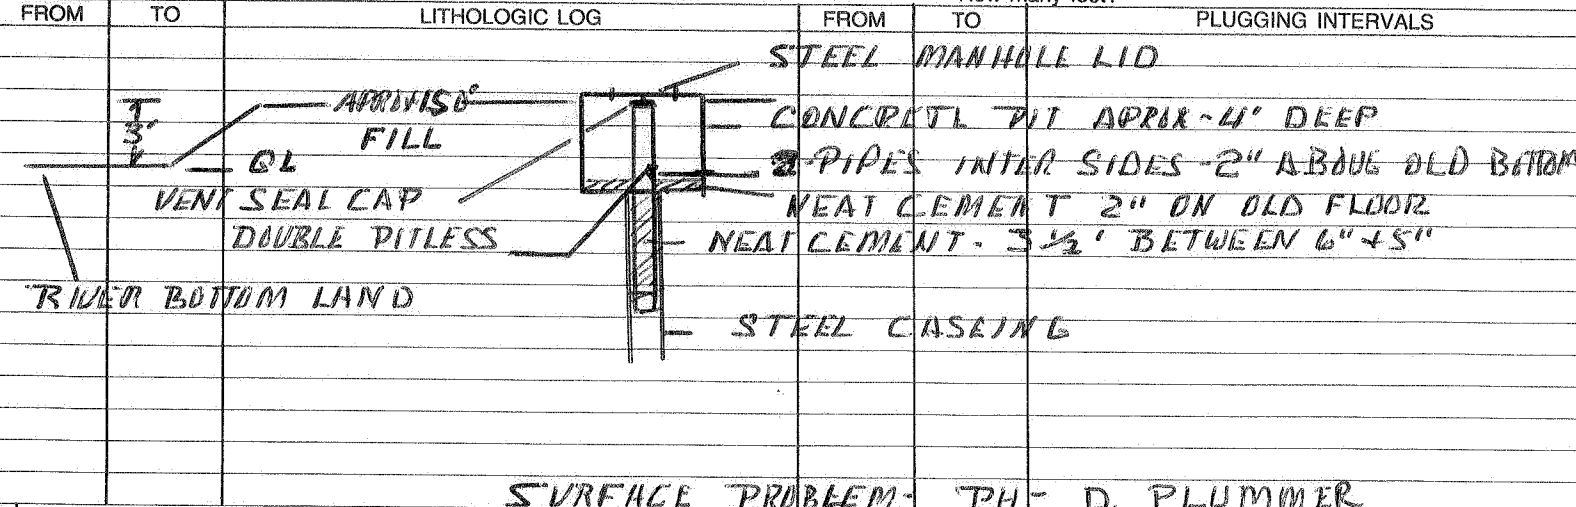

7 CONTRACTOR'S OR LANDOWNER'S CERTIFICATION: This water well was (1) constructed, (2) reconstructed, or (3) plugged under my jurisdiction and was completed on (mo/day/year) 04-13-89 and this record is true to the best of my knowledge and belief. Kansas Water Well Contractor's License No. 479 This Water Well Record was completed on (mo/day/yr) 04-22-89 under the business name of ERBERTS DRILLING by (signature) Aragon Elbert