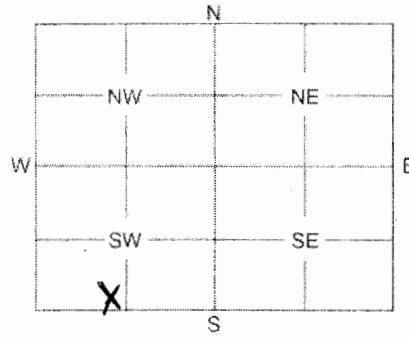


1	LOCATION OF WATER WELL: County: Lyon	Fraction SE 1/4 SW 1/4 SW 1/4	Section Number 10	Township Number 18	Range Number 11
---	--	---	-----------------------------	------------------------------	---------------------------

Distance and direction from nearest town or city street address of well if located within city?

602 State Street, Emporia, Kansas

2	WATER WELL OWNER: Town and Country #30	RR #, St. Address, Box #: 1522 S. Florence	Board of Agriculture, Division of Water Resources
	City, State, ZIP Code: Wichita, Ks 67209	Application Number:	

3	MARK WELL'S LOCATION WITH AN "X" IN SECTION BOX: 	4	DEPTH OF WELL 39.5 ft. WELL'S STATIC WATER LEVEL 32.2 ft. WELL WAS USED AS: 1 Domestic 2 Irrigation 3 Feedlot 4 Industrial 5 Public Water Supply 6 Oil Field Water Supply 7 Domestic (Lawn & Garden) 8 Air Conditioning 9 Dewatering 10 Monitoring Well 11 Injection Well 12 Other
---	---	---	---

Was a chemical / bacteriological sample submitted to Department? Yes No **X**.....
If yes, mo/day/yr sample was submitted

Water Well Disinfected: Yes No **X**.....

5	TYPE OF BLANK CASING USED: 1 Steel 2 PVC 3 RMP (SR) 4 ABS 5 Wrought 6 Asbestos-Cement 7 Fiberglass 8 Concrete Tile 9 Other (Specify below)
---	--

Blank casing diameter **2** in. Was casing pulled? Yes **X**..... No If yes, how much **20'**.....
Casing height above or below land surface


6	GROUT PLUG MATERIAL: 1 Neat cement 2 Cement grout 3 Bentonite 4 Other Surface silts and clays
---	---

GROUT PLUG INTERVALS: From **20** ft. to **5** ft., From **5** ft. to **0** ft., From to ft.

What is the nearest source of possible contamination:
1 Septic tank
2 Sewer lines
3 Watertight sewer lines
4 Lateral lines
5 Cess pool
6 Seepage pit
7 Pit privy
8 Sewage lagoon
9 Feedyard
10 Livestock pens
11 Fuel storage
12 Fertilizer storage
13 Insecticide storage
14 Abandoned water well
15 Oil well/Gas well
16 **Other (specify below)**
cont. silt

Direction from well? How many feet?

FROM	TO	PLUGGING MATERIALS
20	.5	Bentonite
.5	0	Concrete cap

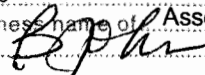7	CONTRACTOR'S OF LANDOWNER'S CERTIFICATION: This water well was plugged under my jurisdiction and was completed on (mo/day/year) 06/14/05 and this record is true to the best of my knowledge and belief. Kansas Water Well Contractor's License No. 585 . This Water Well Record was completed on (mo/day/year) 06/21/05 under the business name of Associated Environmental, Inc. by (signature) Bradley J. Johnson 
---	--

INSTRUCTIONS: Use typewriter or ball point pen. Please press firmly and print clearly. Please fill in blanks, underline or circle the correct answers. Send top three copies to Kansas Department of Health and Environment, Bureau of Water, Geology Section, 1000 SW Jackson St., Ste. 420, Topeka, Kansas 66612-1367. Telephone: 785/296-5522. Send one to Water Well Owner and retain one for your records.