

CORRECTION(S) TO WATER WELL RECORD (WWC-5)

(to rectify lacking or incorrect information)

Location listed as:

Section-Township-Range: 7-18-11

Fraction (  $\frac{1}{4}$   $\frac{1}{4}$   $\frac{1}{4}$ ): SE

County: Lyon

Location changed to:

7-18-5-11 E

SE SE SE

Other changes: Initial statements: Date: 11-11-07

Changed to: 11-11-06

Comments: \_\_\_\_\_

verification method: Legal description, well owner's address, area road map, position on plat map, and mapping tool & aerial photos on KGS website. initials: DRd date: 8/14/2007

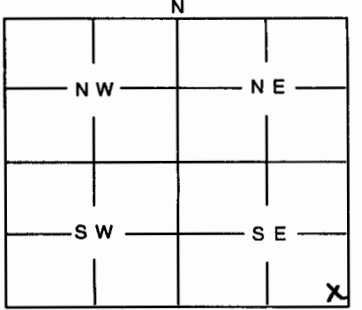
submitted by: Kansas Geological Survey, Data Resources Library, 1930 Constant Ave., Lawrence, KS 66047-3726

to: Kansas Dept of Health & Environment, Bureau of Water, 1000 SW Jackson, Suite 420, Topeka, KS 66612-1367.

1 LOCATION OF WATER WELL: Fraction Section Number Township Number Range Number  
 County: LYON SE 1/4 1/4 1/4 7 18 11

Distance and direction from nearest town or city street address of well if located within city?

2 WATER WELL OWNER: Gabe Hignsland  
 RR #, St. Address, Box #: 786 Road 230  
 City, State, ZIP Code: AMERICUS, KS 66835  
 Board of Agriculture, Division of Water Resources  
 Application Number:

3 MARK WELL'S LOCATION WITH AN "X" IN SECTION BOX:  


4 DEPTH OF WELL 20 ft  
 WELL'S STATIC WATER LEVEL 1 ft  
 WELL WAS USED AS:  
 1 Domestic      5 Public Water Supply      9 Dewatering  
 2 Irrigation      6 Oil Field Water Supply      10 Monitoring Well  
 3 Feedlot      7 Domestic (Lawn & Garden)      11 Injection Well  
 4 Industrial      8 Air Conditioning      12 Other .....

Was a chemical / bacteriological sample submitted to Department? Yes ..... No X  
 If yes, mo/day/yr sample was submitted .....

Water Well Disinfected: Yes X No .....

5 TYPE OF BLANK CASING USED:  
 1 Steel      3 RMP (SR)      5 Wrought      7 Fiberglass      9 Other (Specify below) Rock  
 2 PVC      4 ABS      6 Asbestos-Cement      8 Concrete Tile  
 Blank casing diameter 36 in.      Was casing pulled? Yes X No .....      If yes, how much 577 in.  
 Casing height above or below land surface 60 in.

6 GROUT PLUG MATERIAL: 1 Neat cement      2 Cement grout      3 Bentonite      4 Other .....

Grout Plug Intervals: From 5 ft. to 4.5 ft., From ..... ft. to ..... ft., From ..... to ..... ft.

What is the nearest source of possible contamination:  
 1 Septic tank      6 Seepage pit      11 Fuel storage      16 Other (specify below)  
 2 Sewer lines      7 Pit privy      12 Fertilizer storage  
 3 Watertight sewer lines      8 Sewage lagoon      13 Insecticide storage  
 4 Lateral lines      9 Feedyard      14 Abandoned water well  
 5 Cess Pool      10 Livestock pens      15 Oil well/Gas well

Direction from well? West      How many feet? 150

FROM	TO	PLUGGING MATERIALS
20	19	gravel
19	5	subsoil
5	4.5	Bentonite
4.5	0	Top soil

7 CONTRACTOR'S OR LANDOWNER'S CERTIFICATION: This water well was plugged under my jurisdiction and was completed on (mo/day/year) 11-11-07 and this record is true to the best of my knowledge and belief. Kansas Water Well Contractor's License No. .... This Water Well Record was completed on (mo/day/year) .....  
 under the business name of .....  
 by (signature) Gabe Hignsland

INSTRUCTIONS: Use typewriter or ball point pen. Please press firmly and print clearly. Please fill in blanks, underline or circle the correct answers. Send top three copies to Kansas Department of Health and Environment, Bureau of Water, Topeka, Kansas 66620-0001. Telephone: 785/296-3565. Send one to Water Well Owner and retain one for your records.