WATER WELL RECORD Form WWC-5 KSA 82a-1212

1 LOCATION OF WATER WELL:

County:	Fraction	Section Number	Township Number	Range Number
LYON	SE ¼ SW ¼ SE ¼	33	T 18 S	R 13 E/W

Distance and direction from nearest town or city street address of well if located within city?
HWY I35 + HARTFORD EXIT - N TO OLD HWY 50 - 1ST RD N - 3/4 M E 1ST GOING E

2 WATER WELL OWNER: * BRADLY KEATING
RR#, St. Address, Box #: RT 2 - BOX 57 - READING KS - 66868
City, State, ZIP Code:
Board of Agriculture, Division of Water Resources Application Number:

3 LOCATE WELL'S LOCATION WITH AN "X" IN SECTION BOX:

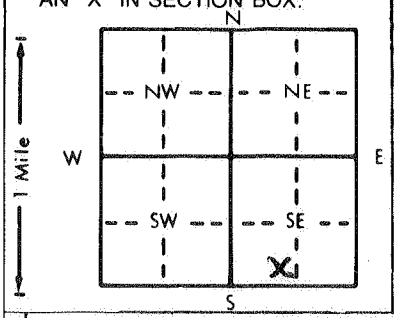

4 DEPTH OF COMPLETED WELL 28 ft. ELEVATION: –
Depth(s) Groundwater Encountered 1. UNKNOWN ft. 2. – ft. 3. – ft.
WELL'S STATIC WATER LEVEL 23.5 ft. below land surface measured on mo/day/yr 06-26-91
Pump test data: Well water was NA ft. after – hours pumping – gpm
Est. Yield NA gpm: Well water was – ft. after – hours pumping – gpm
Bore Hole Diameter 48 in. to 28 ft., and – in. to – ft.
WELL WATER TO BE USED AS: 1 Domestic 2 Irrigation 3 Feedlot 4 Industrial 5 Public water supply 6 Oil field water supply 7 Lawn and garden only 8 Air conditioning 9 Dewatering 10 Monitoring well – 11 Injection well 12 Other (Specify below)
Was a chemical/bacteriological sample submitted to Department? Yes ..... No X ; If yes, mo/day/yr sample was submitted –
Water Well Disinfected? Yes X No –

5 TYPE OF BLANK CASING USED: 1 Steel 2 PVC 3 RMP (SR) 4 ABS 5 Wrought iron 6 Asbestos-Cement 7 Fiberglass 8 Concrete tile 9 Other (specify below) –
CASING JOINTS: Glued X Clamped – Welded – Threaded –
Blank casing diameter 6 in. to 28 ft., Dia – in. to – ft., Dia – in. to – ft.
Casing height above land surface * 12 in., weight SCH 40 lbs./ft. Wall thickness or gauge No. –
TYPE OF SCREEN OR PERFORATION MATERIAL: 1 Steel 2 Brass 3 Stainless steel 4 Galvanized steel 5 Fiberglass 6 Concrete tile 7 PVC 8 RMP (SR) 9 ABS 10 Asbestos-cement 11 Other (specify) – 12 None used (open hole)
SCREEN OR PERFORATION OPENINGS ARE: 1 Continuous slot 2 Louvered shutter 3 Mill slot 4 Key punched 5 Gauzed wrapped 6 Wire wrapped 7 Torch cut 8 Saw cut 9 Drilled holes 10 Other (specify) – 11 None (open hole)
SCREEN-PERFORATED INTERVALS: From 23 ft. to 28 ft., From – ft. to – ft.
From – ft. to – ft., From – ft. to – ft.
GRAVEL PACK INTERVALS: From 22 ft. to 28 ft., From – ft. to – ft.
From – ft. to – ft., From – ft. to – ft.

6 GROUT MATERIAL: 1 Neat cement 2 Cement grout 3 Bentonite 4 Other –
Grout Intervals: From 5 ft. to 5.5 ft., From – ft. to – ft., From – ft. to – ft.
What is the nearest source of possible contamination:
1 Septic tank 2 Sewer lines 3 Watertight sewer lines 4 Lateral lines 5 Cess pool 6 Seepage pit 7 Pit privy 8 Sewage lagoon 9 Feedyard 10 Livestock pens 11 Fuel storage 12 Fertilizer storage 13 Insecticide storage 14 Abandoned water well 15 Oil well/Gas well 16 Other (specify below) –
Direction from well? W - DOWN SLOPE How many feet? 40' - 120'

FROM	TO	LITHOLOGIC LOG	FROM	TO	PLUGGING INTERVALS
–	–	UNKNOWN		GL	
		HAND DUG - NO RECORD.			
		REMOVED ROCK WALL			
			BENTONITE		BACK FILL
		* WORK WAS DONE FOR BOTH			
		SELLER AND BUYER:			
		NEW OWNER AS OF 06-28-91			
		LISTED ABOVE - SELLER	31	5.6'	Ø1 Clay / Bentonite
		BRAIN THAYER - SAME AS			
		ABOVE AS OF THIS DATE –			

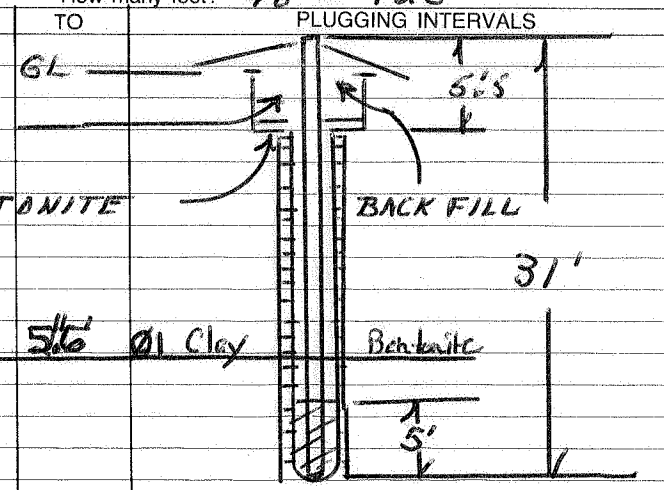

7 CONTRACTOR'S OR LANDOWNER'S CERTIFICATION: This water well was (1) constructed, (2) reconstructed, or (3) plugged under my jurisdiction and was completed on (mo/day/year) 06-26-91 and this record is true to the best of my knowledge and belief. Kansas Water Well Contractor's License No. 479 This Water Well Record was completed on (mo/day/yr) 06-27-91 under the business name of EBBERTS DRILLING by (signature) Duane Ebbert

INSTRUCTIONS: Use typewriter or ball point pen. *PLEASE PRESS FIRMLY* and *PRINT* clearly. Please fill in blanks, underline or circle the correct answers. Send top three copies to Kansas Department of Health and Environment, Bureau of Water, Topeka, Kansas 66620-7320. Telephone: 913-296-5545. Send one to WATER WELL OWNER and retain one for your records.