


1 LOCATION OF WATER WELL: County: **OSAGE** Fraction: **NW 1/4 NW 1/4 NW 1/4** Section Number: **23** Township Number: **T 18 S** Range Number: **R 13 EW**

Distance and direction from nearest town or city street address of well if located within city?
3 MILES SOUTH APPROX 1310' EAST - 80'S OF INSECT. CO. RD & HW - EASTSIDE-READING

2 WATER WELL OWNER: **CURTIS PALMER**
 RR#, St. Address, Box #: **ROUTE 2 BOX 28** Board of Agriculture, Division of Water Resources
 City, State, ZIP Code: **READING KS 66868** Application Number:

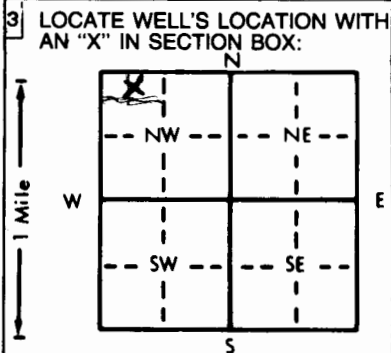

4 DEPTH OF COMPLETED WELL: **30** ft. ELEVATION: _____
 Depth(s) Groundwater Encountered 1. **8** ft. 2. _____ ft. 3. _____ ft.
 WELL'S STATIC WATER LEVEL: **1.5** ft. below land surface measured on mo/day/yr **08-07-87**
 Pump test data: Well water was _____ ft. after _____ hours pumping _____ gpm
 Est. Yield: **1.5** gpm; Well water was _____ ft. after _____ hours pumping _____ gpm
 Bore Hole Diameter: **12** in. to **15** ft., and **10** in. to **30** ft.
 WELL WATER TO BE USED AS:
 1 Domestic 3 Feedlot 6 Oil field water supply 9 Dewatering 12 Other (Specify below)
 2 Irrigation 4 Industrial 7 Lawn and garden only 10 Observation well
 Was a chemical/bacteriological sample submitted to Department? Yes _____ No _____; If yes, mo/day/yr sample was submitted **TO BE TAKEN WK 4 08-10-87** Water Well Disinfected? Yes **XX** No

5 TYPE OF BLANK CASING USED:
 1 Steel 3 RMP (SR) 5 Wrought iron 8 Concrete tile CASING JOINTS: Glued Clamped _____
 2 PVC 4 ABS 6 Asbestos-Cement 9 Other (specify below) Welded _____
 7 Fiberglass _____ Threaded _____
 Blank casing diameter: **6** in. to **30** ft., Dia _____ in. to _____ ft., Dia _____ in. to _____ ft.
 Casing height above land surface: **7.7** in., weight _____ lbs./ft. Wall thickness or gauge No. **SCH 40**

TYPE OF SCREEN OR PERFORATION MATERIAL:
 1 Steel 3 Stainless steel 5 Fiberglass 8 RMP (SR) 10 Asbestos-cement 11 Other (specify) _____
 2 Brass 4 Galvanized steel 6 Concrete tile 9 ABS 12 None used (open hole)

SCREEN OR PERFORATION OPENINGS ARE:
 1 Continuous slot 3 Mill slot 5 Gauzed wrapped 8 Saw cut 11 None (open hole)
 2 Louvered shutter 4 Key punched 6 Wire wrapped 9 Drilled holes
 7 Torch cut 10 Other (specify) _____

SCREEN-PERFORATED INTERVALS: From **7** ft. to **30** ft., From _____ ft. to _____ ft.
 From _____ ft. to _____ ft., From _____ ft. to _____ ft.
 GRAVEL PACK INTERVALS: From **6** ft. to **30** ft., From **1200' Pea Gravel** ft. to _____ ft.
 From _____ ft. to _____ ft., From _____ ft. to _____ ft.

6 GROUT MATERIAL: 1 Neat cement 2 Cement grout 3 Bentonite 4 Other _____
 Grout Intervals: From **6** ft. to **6 1/2** ft., From _____ ft. to _____ ft., From _____ ft. to _____ ft.
 What is the nearest source of possible contamination:
 1 Septic tank 4 Lateral lines 7 Pit privy 10 Livestock pens 14 Abandoned water well
 2 Sewer lines 5 Cess pool 8 Sewage lagoon 11 Fuel storage 15 Oil well/Gas well
 3 Watertight sewer lines 6 Seepage pit 9 Feedyard 12 Fertilizer storage 16 Other (specify below)
 13 Insecticide storage **PIT SIKO**
 Direction from well? **E** How many feet? **80**

FROM	TO	LITHOLOGIC LOG	FROM	TO	LITHOLOGIC LOG
6h'	2'	TOP SOIL			
2'	6'	SILT			
6'	6'-4"	LIME STONE - BROKEN			
6'-4"	8'	CLAY-SILT-			
8'	8'-6"	LIME STONE - (WATER ON TOP)			
8'-6"	20'	LT GREY SD SHALE			
20'	30'	DRK GREY SD SHALE			

7 CONTRACTOR'S OR LANDOWNER'S CERTIFICATION: This water well was (1) constructed, (2) reconstructed, or (3) plugged under my jurisdiction and was completed on (mo/day/year) **08-06-87** and this record is true to the best of my knowledge and belief. Kansas Water Well Contractor's License No. **479** This Water Well Record was completed on (mo/day/yr) **08-07-87** under the business name of **EBBERTS DRILLING** by (signature) *Morgan Ebert*

INSTRUCTIONS: Use typewriter or ball point pen. PLEASE PRESS FIRMLY and PRINT clearly. Please fill in blanks, underline or circle the correct answers. Send top three copies to Kansas Department of Health and Environment, Office of Oil Field and Environmental Geology, Regulation and Permitting Section, Topeka, Kansas 66620-7500, Telephone: 913-862-9360. Send one to WATER WELL OWNER and retain one for your records.

OFFICE USE ONLY

T

R

EW

SEC.

14

14

14