

**WATER WELL PLUGGING RECORD Form WWC-5P**

KSA 82a-1212


ID NO.

20663

**1 LOCATION OF WATER WELL:** Fraction NW 1/4 NW 1/4 NW 1/4 SW 1/4 Section Number 2 Township Number T 18 S Range Number 16  E  W  
 County: Osage

Street/Rural Address of Well Location; if unknown, distance & direction from nearest town or intersection: If at owner's address, check here  Well is located 1&1/4 miles n.e. on 305th st  
**Global Positioning Systems (GPS) information:**  
 Latitude: 38.514282 (in decimal degrees)  
 Longitude: -95.619224 (in decimal degrees)  
 Elevation: \_\_\_\_\_  
 Horizontal Datum:  WGS84,  NAD83,  NAD27  
 Collection Method: \_\_\_\_\_

**2 WATER WELL OWNER:** 121 N.W. main st p.o. box 116 RR#, St. Address, Box #:  
Melvern ks. 66510  
 City, State ZIP Code: Melvern ks. 66510  
 GPS unit (Make/Model: \_\_\_\_\_)  
 Digital Map/Photo,  Topographic Map,  Land Survey  
 Est. Accuracy:  < 3 m,  3-5 m,  5-15 m,  > 15 m

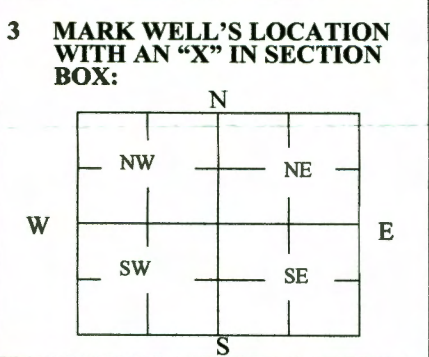

**4 DEPTH OF WELL** 110 ft.  
 WELL'S STATIC WATER LEVEL 25 ft.  
 WELL WAS USED AS:  
 Domestic  Public Water Supply #3  
 Irrigation  Oil Field Water Supply  
 Feedlot  Domestic (Lawn & Garden)  
 Industrial  Air Conditioning  Dewatering  
 Monitoring  
 Injection Well  
 Other \_\_\_\_\_  
 Was a chemical/bacteriological sample submitted to Department? Yes  No

**5 TYPE OF BLANK CASING USED:**  
 Steel  RMP (SR)  Wrought  Fiberglass  Other (Specify below) \_\_\_\_\_  
 PVC  ABS  Asbestos-Cement  Concrete Tile  
 Blank casing diameter 6 in. Was casing pulled? Yes  No  If yes, how much \_\_\_\_\_  
 Casing height above or below land surface above 8 in.

**6 GROUT PLUG MATERIAL:**  Neat cement  Cement grout  Bentonite  Other \_\_\_\_\_  
 Grout Plug Intervals: From 0 ft. to 2 ft., From 2 ft. to 23 ft., From \_\_\_\_\_ ft. to \_\_\_\_\_ ft.  
 What is the nearest source of possible contamination:  
 Septic tank  Seepage pit  Fuel storage  Other (specify below) \_\_\_\_\_  
 Sewer lines  Pit privy  Fertilizer storage  
 Watertight sewer lines  Sewage lagoon  Insecticide storage  
 Lateral lines  Feedyard  Abandoned water well Direction from well? North  
 Cess pool  Livestock pens  Oil well/Gas well How many feet? APPROX. 400 FT

FROM	TO	PLUGGING MATERIALS	FROM	TO	PLUGGING MATERIALS
0	2	Cement Grout			
2	23	Bentonite			could not remove casing plugged well even with the concrete slab
23	110	Limestone screenings			
		<i>Added 1 gal Chlorine Bleach</i>			

**7 CONTRACTOR'S OR LANDOWNER'S CERTIFICATION:** This water well was plugged under my jurisdiction and was completed on (mo/day/year) 05/08 2019 and this record is true to the best of my knowledge and belief. Kansas Water Well Contractor's License No. N/A. This Water Well Record was completed on (mo/day/year) 05/09/2019 under the business name of City of Melvern by (signature) Gary Kitt

Send one white copy to Kansas Department of Health & Environment, Geology Section, 1000 SW Jackson Street, Ste. 420, Topeka, KS 66612-1367. Send one copy to WATER WELL OWNER and retain one for your records.  
 Visit us at <http://www.kdheks.gov/waterwell/index.html> Telephone 785-296-5524.