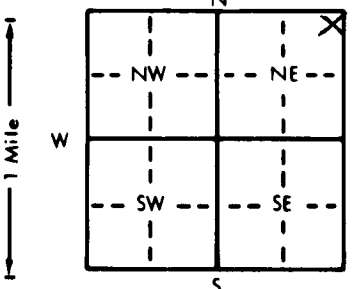


1 LOCATION OF WATER WELL: County: <u>Franklin</u>		Fraction: <u>NE 1/4 NE 1/4 NE 1/4</u>	Section Number: <u>12</u>	Township Number: <u>T 18 S</u>	Range Number: <u>R 17 E</u>
Distance and direction from nearest town or city street address of well if located within city? <u>Williamsburg 1 1/2 North</u>					
2 WATER WELL OWNER: RR#, St. Address, Box # : City, State, ZIP Code : <u>Williamsburg</u>		Board of Agriculture, Division of Water Resources Application Number: <u>none available</u>			
3 LOCATE WELL'S LOCATION WITH AN "X" IN SECTION BOX: 		4 DEPTH OF COMPLETED WELL: <u>185</u> ft. ELEVATION: <u>175</u> ft. Depth(s) Groundwater Encountered: <u>1</u> ft. 2. <u>175</u> ft. 3. <u>170</u> ft. WELL'S STATIC WATER LEVEL: <u>170</u> ft. below land surface measured on mo/day/yr Pump test data: Well water was <u>1 1/2</u> ft. after <u>185</u> hours pumping <u>185</u> gpm Est. Yield: <u>1 1/2</u> gpm: Well water was <u>10</u> ft. after <u>30</u> hours pumping <u>185</u> gpm Bore Hole Diameter: <u>10</u> in. to <u>30</u> ft., and <u>6 1/4</u> in. to <u>185</u> ft. WELL WATER TO BE USED AS: 1 Domestic 3 Feedlot 6 Oil field water supply 8 Air conditioning 11 Injection well 2 Irrigation 4 Industrial 7 Lawn and garden only 10 Observation well Was a chemical/bacteriological sample submitted to Department? Yes <u>2</u> No <u>185</u> ; If yes, mo/day/yr sample was submitted Water Well Disinfected? Yes <u>2</u> No <u>185</u>			
5 TYPE OF BLANK CASING USED: 1 Steel 3 RMP (SR) 5 Wrought iron 8 Concrete tile CASING JOINTS: <u>Glued</u> <u>Clamped</u> 2 PVC 4 ABS 6 Asbestos-Cement 9 Other (specify below) <u>Welded</u> Blank casing diameter: <u>6 1/4</u> in. to <u>30</u> ft., Dia <u>5 1/2</u> in. to <u>185</u> ft., Dia <u>5</u> in. to <u>185</u> ft. Casing height above land surface: <u>36</u> in., weight <u>Sch 40</u> lbs./ft. Wall thickness or gauge No. <u>Sch 40</u> TYPE OF SCREEN OR PERFORATION MATERIAL: 1 Steel 3 Stainless steel 5 Fiberglass 7 PVC 10 Asbestos-cement 2 Brass 4 Galvanized steel 6 Concrete tile 8 RMP (SR) 11 Other (specify) SCREEN OR PERFORATION OPENINGS ARE: 1 Continuous slot 3 Mill slot 5 Gauzed wrapped 8 Saw cut 11 None (open hole) 2 Louvered shutter 4 Key punched 6 Wire wrapped 9 Drilled holes SCREEN-PERFORATED INTERVALS: From <u>165</u> ft. to <u>185</u> ft., From <u>165</u> ft. to <u>185</u> ft. GRAVEL PACK INTERVALS: From <u>None</u> ft. to <u>185</u> ft., From <u>None</u> ft. to <u>185</u> ft.					
6 GROUT MATERIAL: 1 Neat cement 2 Cement grout 3 Bentonite 4 Other Grout intervals: From <u>0</u> ft. to <u>30</u> ft., From <u>30</u> ft. to <u>185</u> ft. What is the nearest source of possible contamination: 1 Septic tank 4 Lateral lines 7 Pit privy 10 Livestock pens 14 Abandoned water well 2 Sewer lines 5 Cess pool 8 Sewage lagoon 11 Fuel storage 15 Oil well/Gas well 3 Watertight sewer lines 6 Seepage pit 9 Feedyard 12 Fertilizer storage 16 Other (specify below) Direction from well? <u>South West</u> How many feet? <u>500</u>					
LITHOLOGIC LOG FROM TO LITHOLOGIC LOG <u>0 10 Shelly Rock</u> <u>10 30 Shald</u> <u>30 39 Lime</u> <u>39 42 Shald</u> <u>42 47 Lime</u> <u>47 125 Shald</u> <u>125 170 Sanded grey Sand</u> <u>170 185 grey Sand</u> <u>185 185 Lime</u>					
7 CONTRACTOR'S OR LANDOWNER'S CERTIFICATION: This water well was (1) constructed, (2) reconstructed, or (3) plugged under my jurisdiction and was completed on (mo/day/year) <u>April 8 87</u> and this record is true to the best of my knowledge and belief. Kansas Water Well Contractor's License No. <u>469</u> This Water Well Record was completed on (mo/day/yr) <u>5-5-87</u> under the business name of <u>Royce Seward Ballie</u> by (signature) <u>Royce Seward Ballie</u>					
INSTRUCTIONS: Use typewriter or ballpoint pen. PLEASE PRESS FIRMLY and PRINT clearly. Please fill in blanks, underline or circle the correct answers. Send top three copies to Kansas Department of Health and Environment, Bureau of Water Protection, Topeka, Kansas 66620-7320, Telephone: 913-862-9360. Send one to WATER WELL OWNER and retain one for your records.					