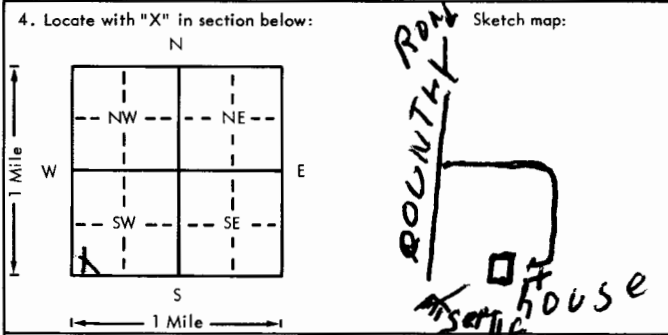


USE TYPEWRITER OR BALL
POINT PEN-PRESS FIRMLY,
PRINT CLEARLY.

WATER WELL RECORD
KSA 82a-1201-1215

Kansas Department of Health and
Environment-Division of Environment
(Water well Contractors)
Topeka, Kansas 66620

1. Location of well:		County franklin	Fraction SW 1/4 SW 1/4 SW 1/4	Section number 26	Township number T 18 S R 17	Range number E/W
2. Distance and direction from nearest town or city: williamsburg Street address of well location if in city: 2 mi. west 2 mi. south			3. Owner of well: Lemuel Drabik R.R. or street: City, state, zip code: williamsburg Kan			
4. Locate with "X" in section below: 			6. Bore hole dia. 6 1/2 in. Completion date 3-9-78 Well depth 80 ft. 9" to 20"			
5. Type and color of material			7. <input checked="" type="checkbox"/> Cable tool <input type="checkbox"/> Rotary <input type="checkbox"/> Driven <input type="checkbox"/> Dug <input type="checkbox"/> Hollow rod <input type="checkbox"/> Jetted <input type="checkbox"/> Bored <input type="checkbox"/> Reverse rotary			
			8. Use: <input checked="" type="checkbox"/> Domestic <input type="checkbox"/> Public supply <input type="checkbox"/> Industry <input type="checkbox"/> Irrigation <input type="checkbox"/> Air conditioning <input type="checkbox"/> Stock <input type="checkbox"/> Lawn <input type="checkbox"/> Oil field water <input type="checkbox"/> Other			
			9. Casing: Material <input type="checkbox"/> Height: Above or <input type="checkbox"/> - Threaded <input type="checkbox"/> Welded <input type="checkbox"/> Surface 18 in. RMP <input type="checkbox"/> PVC <input checked="" type="checkbox"/> Weight pvc lbs./ft. Dia. 6 1/2 in. to 80 ft. depth Wall Thickness: inches or Dia. <input type="checkbox"/> in. to <input type="checkbox"/> ft. depth gauge No. sch 40			
			10. Screen: Manufacturer's name crown line Type pvc Dia. 6 1/2 Slot/gauze 3/8 Length 20 Set between 30 ft. and 50 ft. ft. and <input type="checkbox"/> ft. Gravel pack? no Size range of material <input type="checkbox"/>			
			11. Static water level: 28 ft. below land surface Date 3/78 mo./day/yr.			
			12. Pumping level below land surfaces: <input type="checkbox"/> ft. after <input type="checkbox"/> hrs. pumping <input type="checkbox"/> g.p.m. <input type="checkbox"/> ft. after <input type="checkbox"/> hrs. pumping <input type="checkbox"/> g.p.m. Estimated maximum yield 5 g.p.m.			
			13. Water sample submitted: <input checked="" type="checkbox"/> Yes <input type="checkbox"/> No Date <input type="checkbox"/> mo./day/yr.			
			14. Well head completion: <input type="checkbox"/> Pitless adapter <input type="checkbox"/> inches above grade			
			15. Well grouted? <input checked="" type="checkbox"/> With: <input checked="" type="checkbox"/> Neat cement <input type="checkbox"/> Bentonite <input type="checkbox"/> Concrete Depth: From 0 ft. to 18 ft.			
			16. Nearest source of possible contamination: ft. 100 Direction west Type septic Well disinfected upon completion? <input type="checkbox"/> Yes <input type="checkbox"/> No			
			17. Pump: <input checked="" type="checkbox"/> Not installed Manufacturer's name <input type="checkbox"/> Model number <input type="checkbox"/> HP <input type="checkbox"/> Volts <input type="checkbox"/> Length of drop pipe <input type="checkbox"/> ft. capacity <input type="checkbox"/> g.p.m. Type: <input type="checkbox"/> Submersible <input type="checkbox"/> Turbine <input type="checkbox"/> Jet <input type="checkbox"/> Reciprocating <input type="checkbox"/> Centrifugal <input type="checkbox"/> Other			
18. Elevation:			20. Water well contractor's certification: This well was drilled under my jurisdiction and this report is true to the best of my knowledge and belief. EDGAR SWANK DRILLING, 124 Business name License No. Address PIATAWA KANSAS Signed Edgar Swank Date 5-18-78 Authorized representative			
19. Remarks: THIS WELL WAS DRILLED OUT IN OPEN FIELD						